

CITY OF OAKLAND
 OakDOT | Bicycle & Pedestrian Program
 250 FRANK H. OGAWA PLAZA
 SUITE 4314
 OAKLAND, CA 94612
 (510) 238-3437
 FAX (510) 238-7227

PLANS FOR THE CONSTRUCTION OF TELEGRAPH AVENUE COMPLETE STREETS PROJECT


INDEX OF DRAWINGS CONSTRUCTED BY C369640

ITEM NO.	SHEET NO.	PLAN & TITLE
1	SS-0	TITLE SHEET, LOCATION MAP
2	SS-1	NOTES, LEGEND, AND DETAILS
3	SS-2	STRIPING PLAN
4	SS-3	STRIPING PLAN
5	SS-4	STRIPING PLAN
6	SS-5	STRIPING PLAN
7	SS-6	SIGNING PLAN
8	SS-7	SIGNING PLAN

INDEX OF DRAWINGS CONSTRUCTED BY CITY OF OAKLAND WORK ORDER

ITEM NO.	SHEET NO.	PLAN & TITLE
1 - 6	PM-1 - PM-6	PARKING METER PLAN

CITY PROJECT NO. C369640

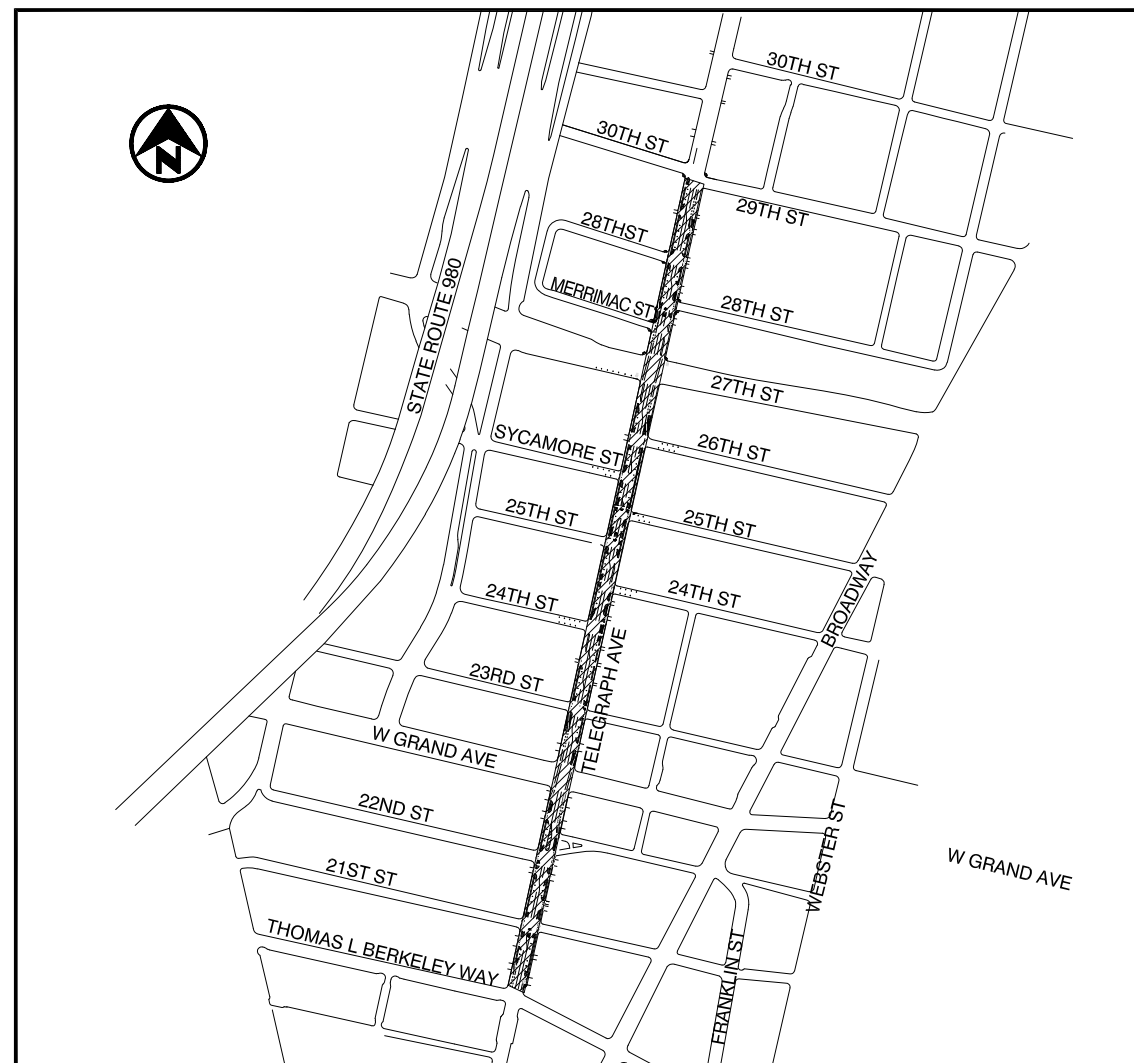


LOCATION MAP

NOT TO SCALE

LIMITS OF WORK

CITY OF OAKLAND MAP

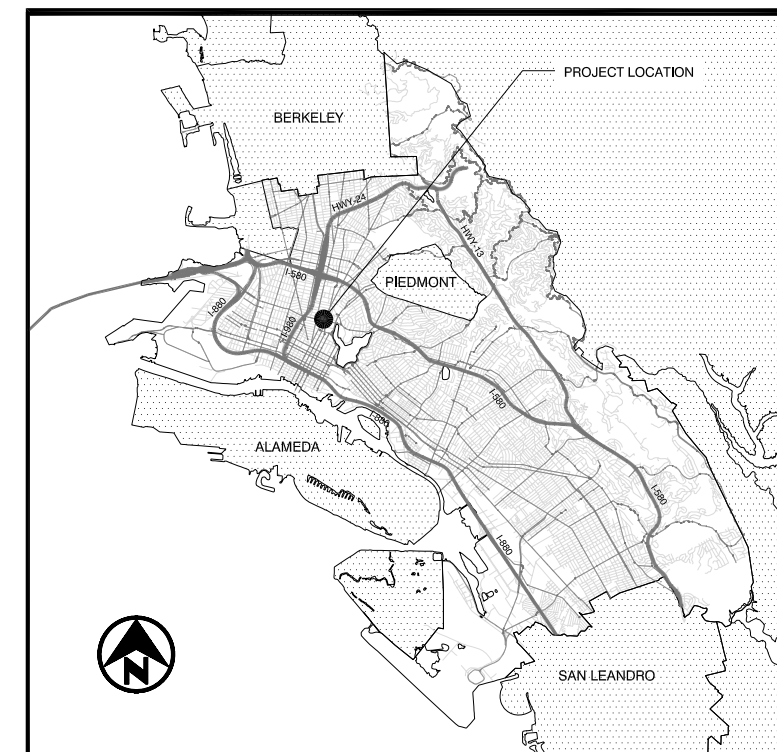

AS-BUILT NOTE: ORIGINAL PLANS BY FEHR & PEERS. AS-BUILT PLANS BY THE CITY OF OAKLAND'S BICYCLE & PEDESTRIAN PROGRAM.

No.	BY	DATE	REFERENCE

FEHR & PEERS
 100 Pringle Avenue Walnut Creek, CA 94596
 Suite 600 (925) 930-7100

CHECKED BY	RR
DESIGNED BY	RM/CN
DRAWN BY	LC/DD



AS-BUILT MAY 2016	PROJECT NO. C369640 PR#11	
	SCALE: AS SHOWN DATE: Feb. 26, 2018	SHEET NO. SS-0 OF

C:\Users\ped\Program\Projects\Bicycles-stripping\TelegraphAve\0_Telegraph_29th-30th\SS12_fml.dwg
 DRAWN BY: LC/DD
 CHECKED BY: RR
 DESIGNED BY: RM/CN
 PLOTTED BY:

SEE SHEET SS-1 FOR CONSTRUCTION NOTES AND LEGEND



GRAPHIC SCALE (IN FEET)

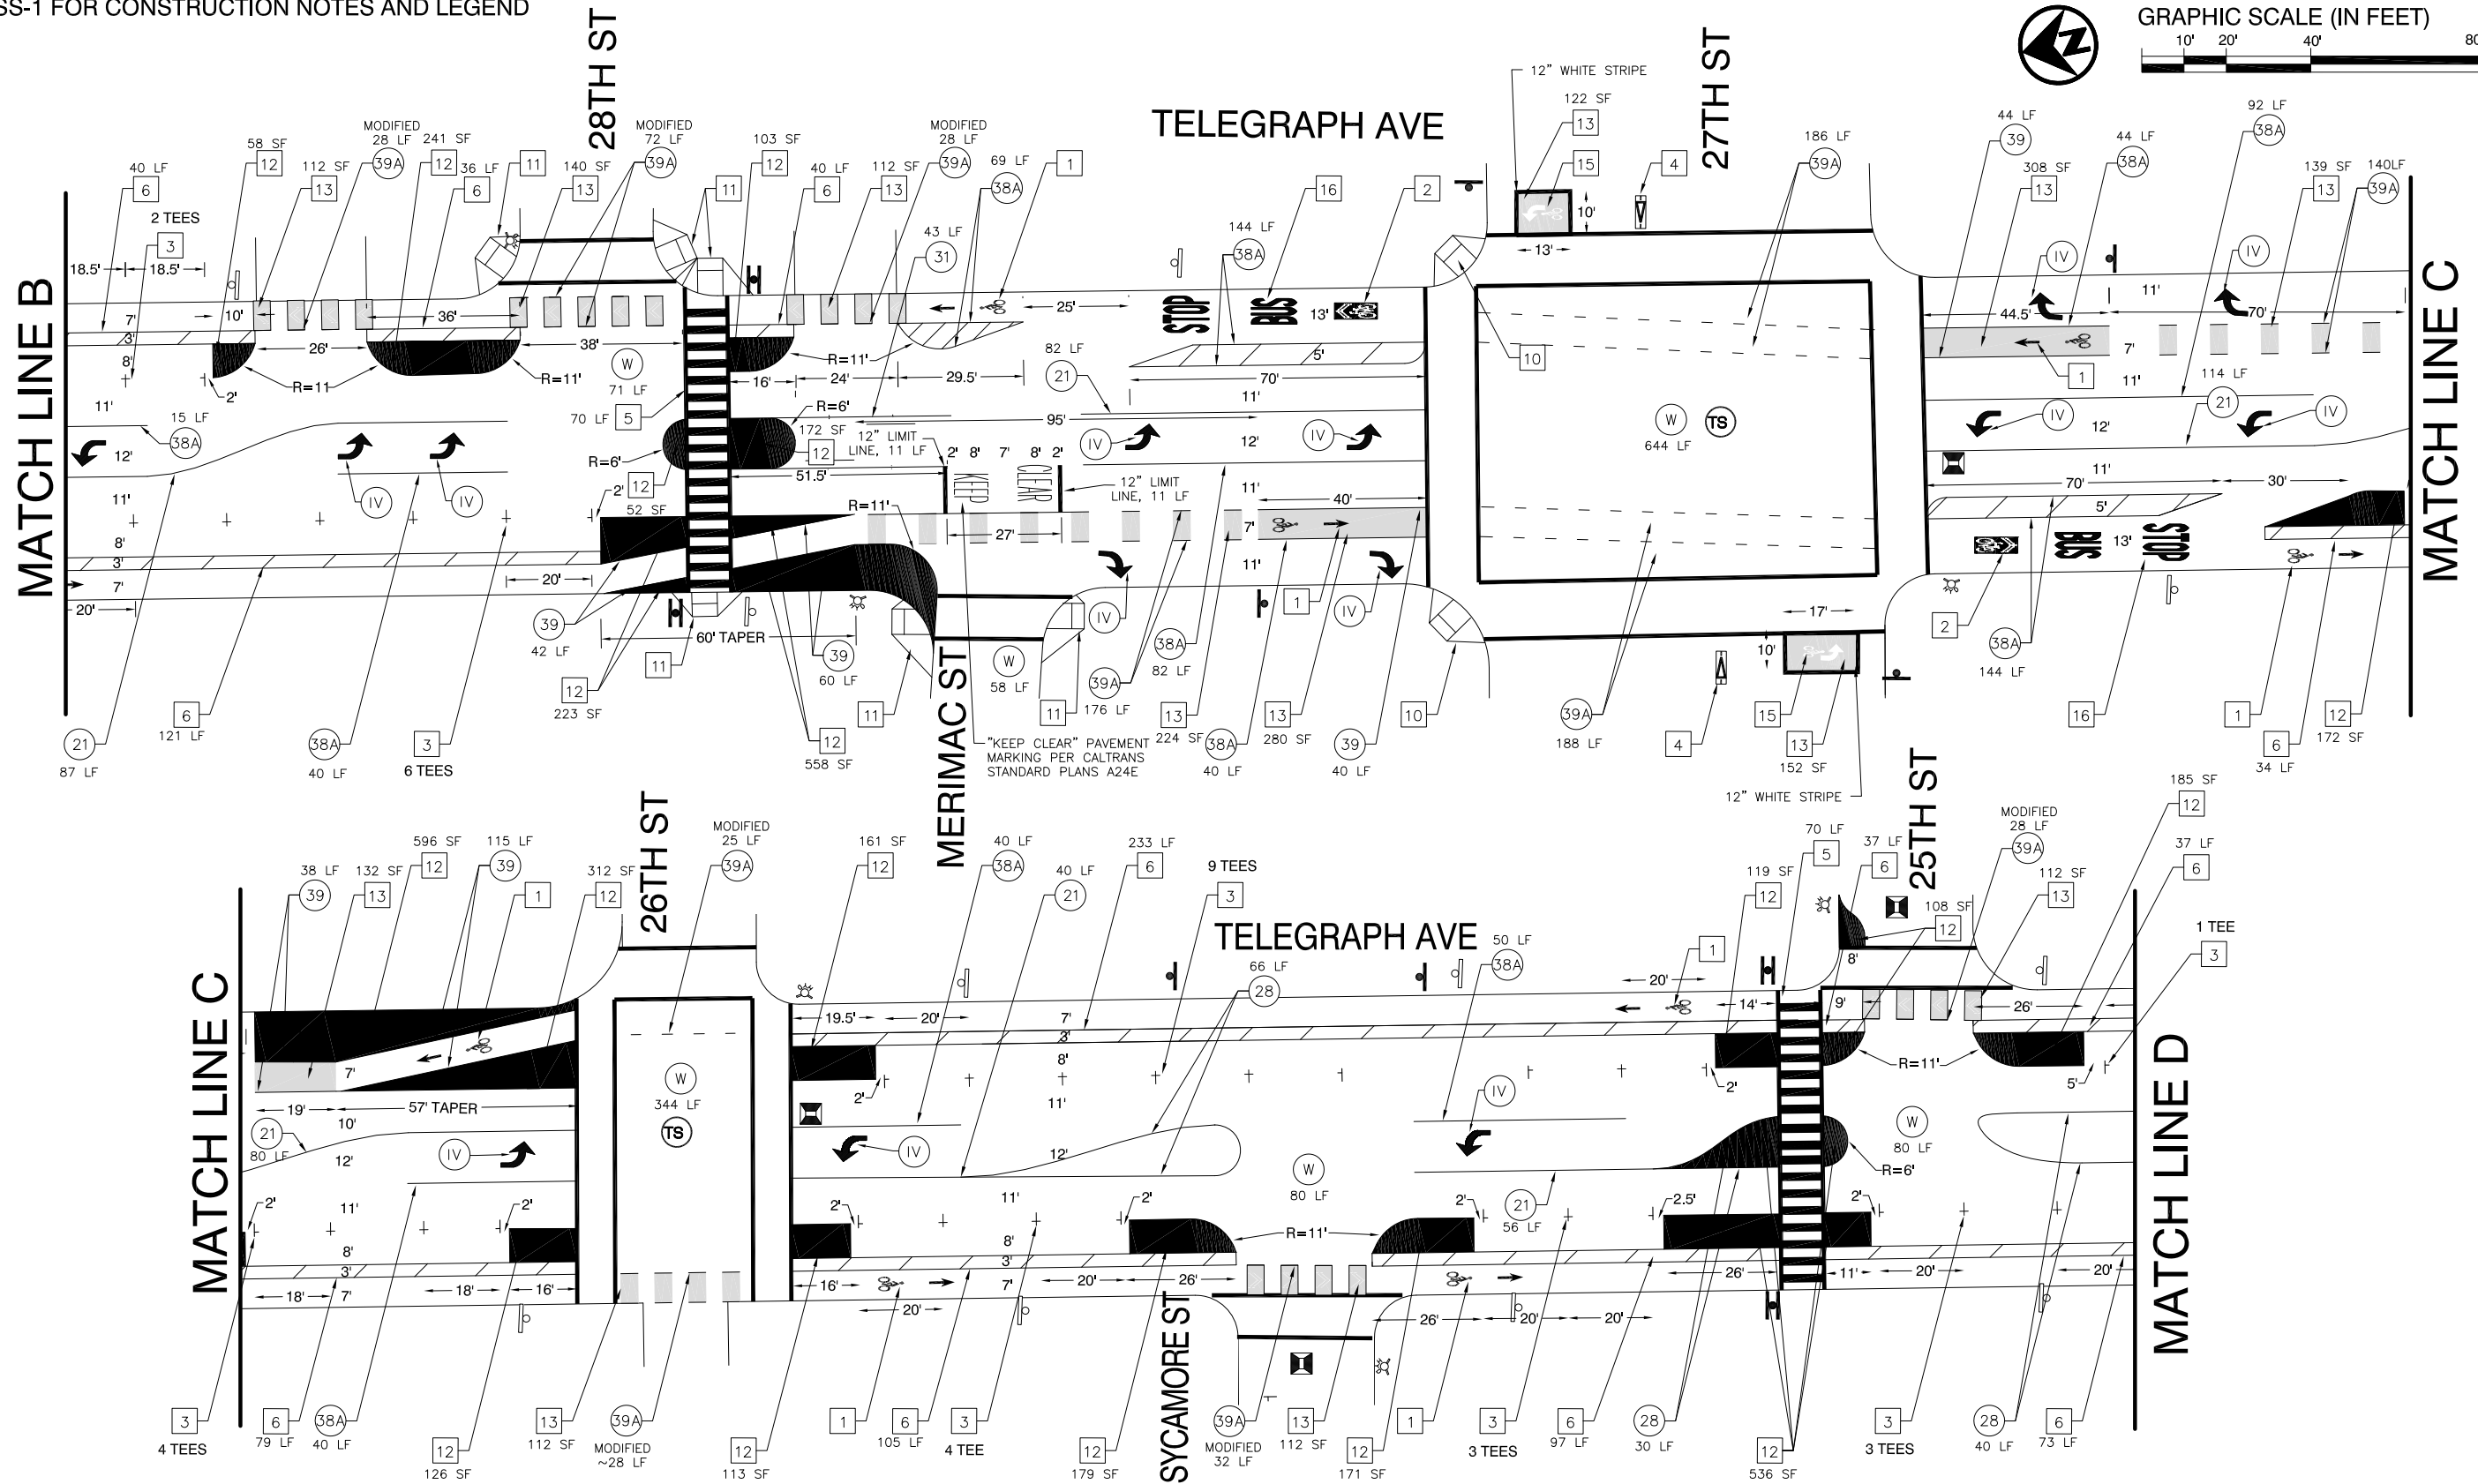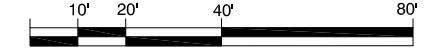

CITY OF OAKLAND

OakDOT | Bicycle and Pedestrian Program
250 FRANK H. OGAWA PLAZA, SUITE 4344 * OAKLAND, CA 94612
(510) 238-3467 * FAX (510) 238-7415

TELEGRAPH AVENUE
COMPLETE STREETS PROJECT
CITY OF OAKLAND

FEHR & PEERS

100 Pringle Avenue Walnut Creek, CA 94596
Suite 600 (925) 930-7100

CHECKED BY	PC/MA
DESIGNED BY	RM/CN
DRAWN BY	LC/CW

No.	BY	DATE	REFERENCE

STRIPING PLAN

AS-BUILT
MAY 2016

PROJECT NO.
C369640
PR# 11

SCALE:
AS SHOWN
DATE:
Feb. 26, 2018




SHEET NO.
SS-3
3 OF 7

DRAWN BY: LC/CW; CHECKED BY: PC/MA; DESIGNED BY: RM/CN; PROJECT: TELEGRAPH AVENUE COMPLETE STREETS PROJECT; SHEET: SS-3; DATE: MAY 2016; PLOTTED BY: LC/CW

SEE SHEET SS-1 FOR CONSTRUCTION NOTES AND LEGEND



GRAPHIC SCALE (IN FEET)

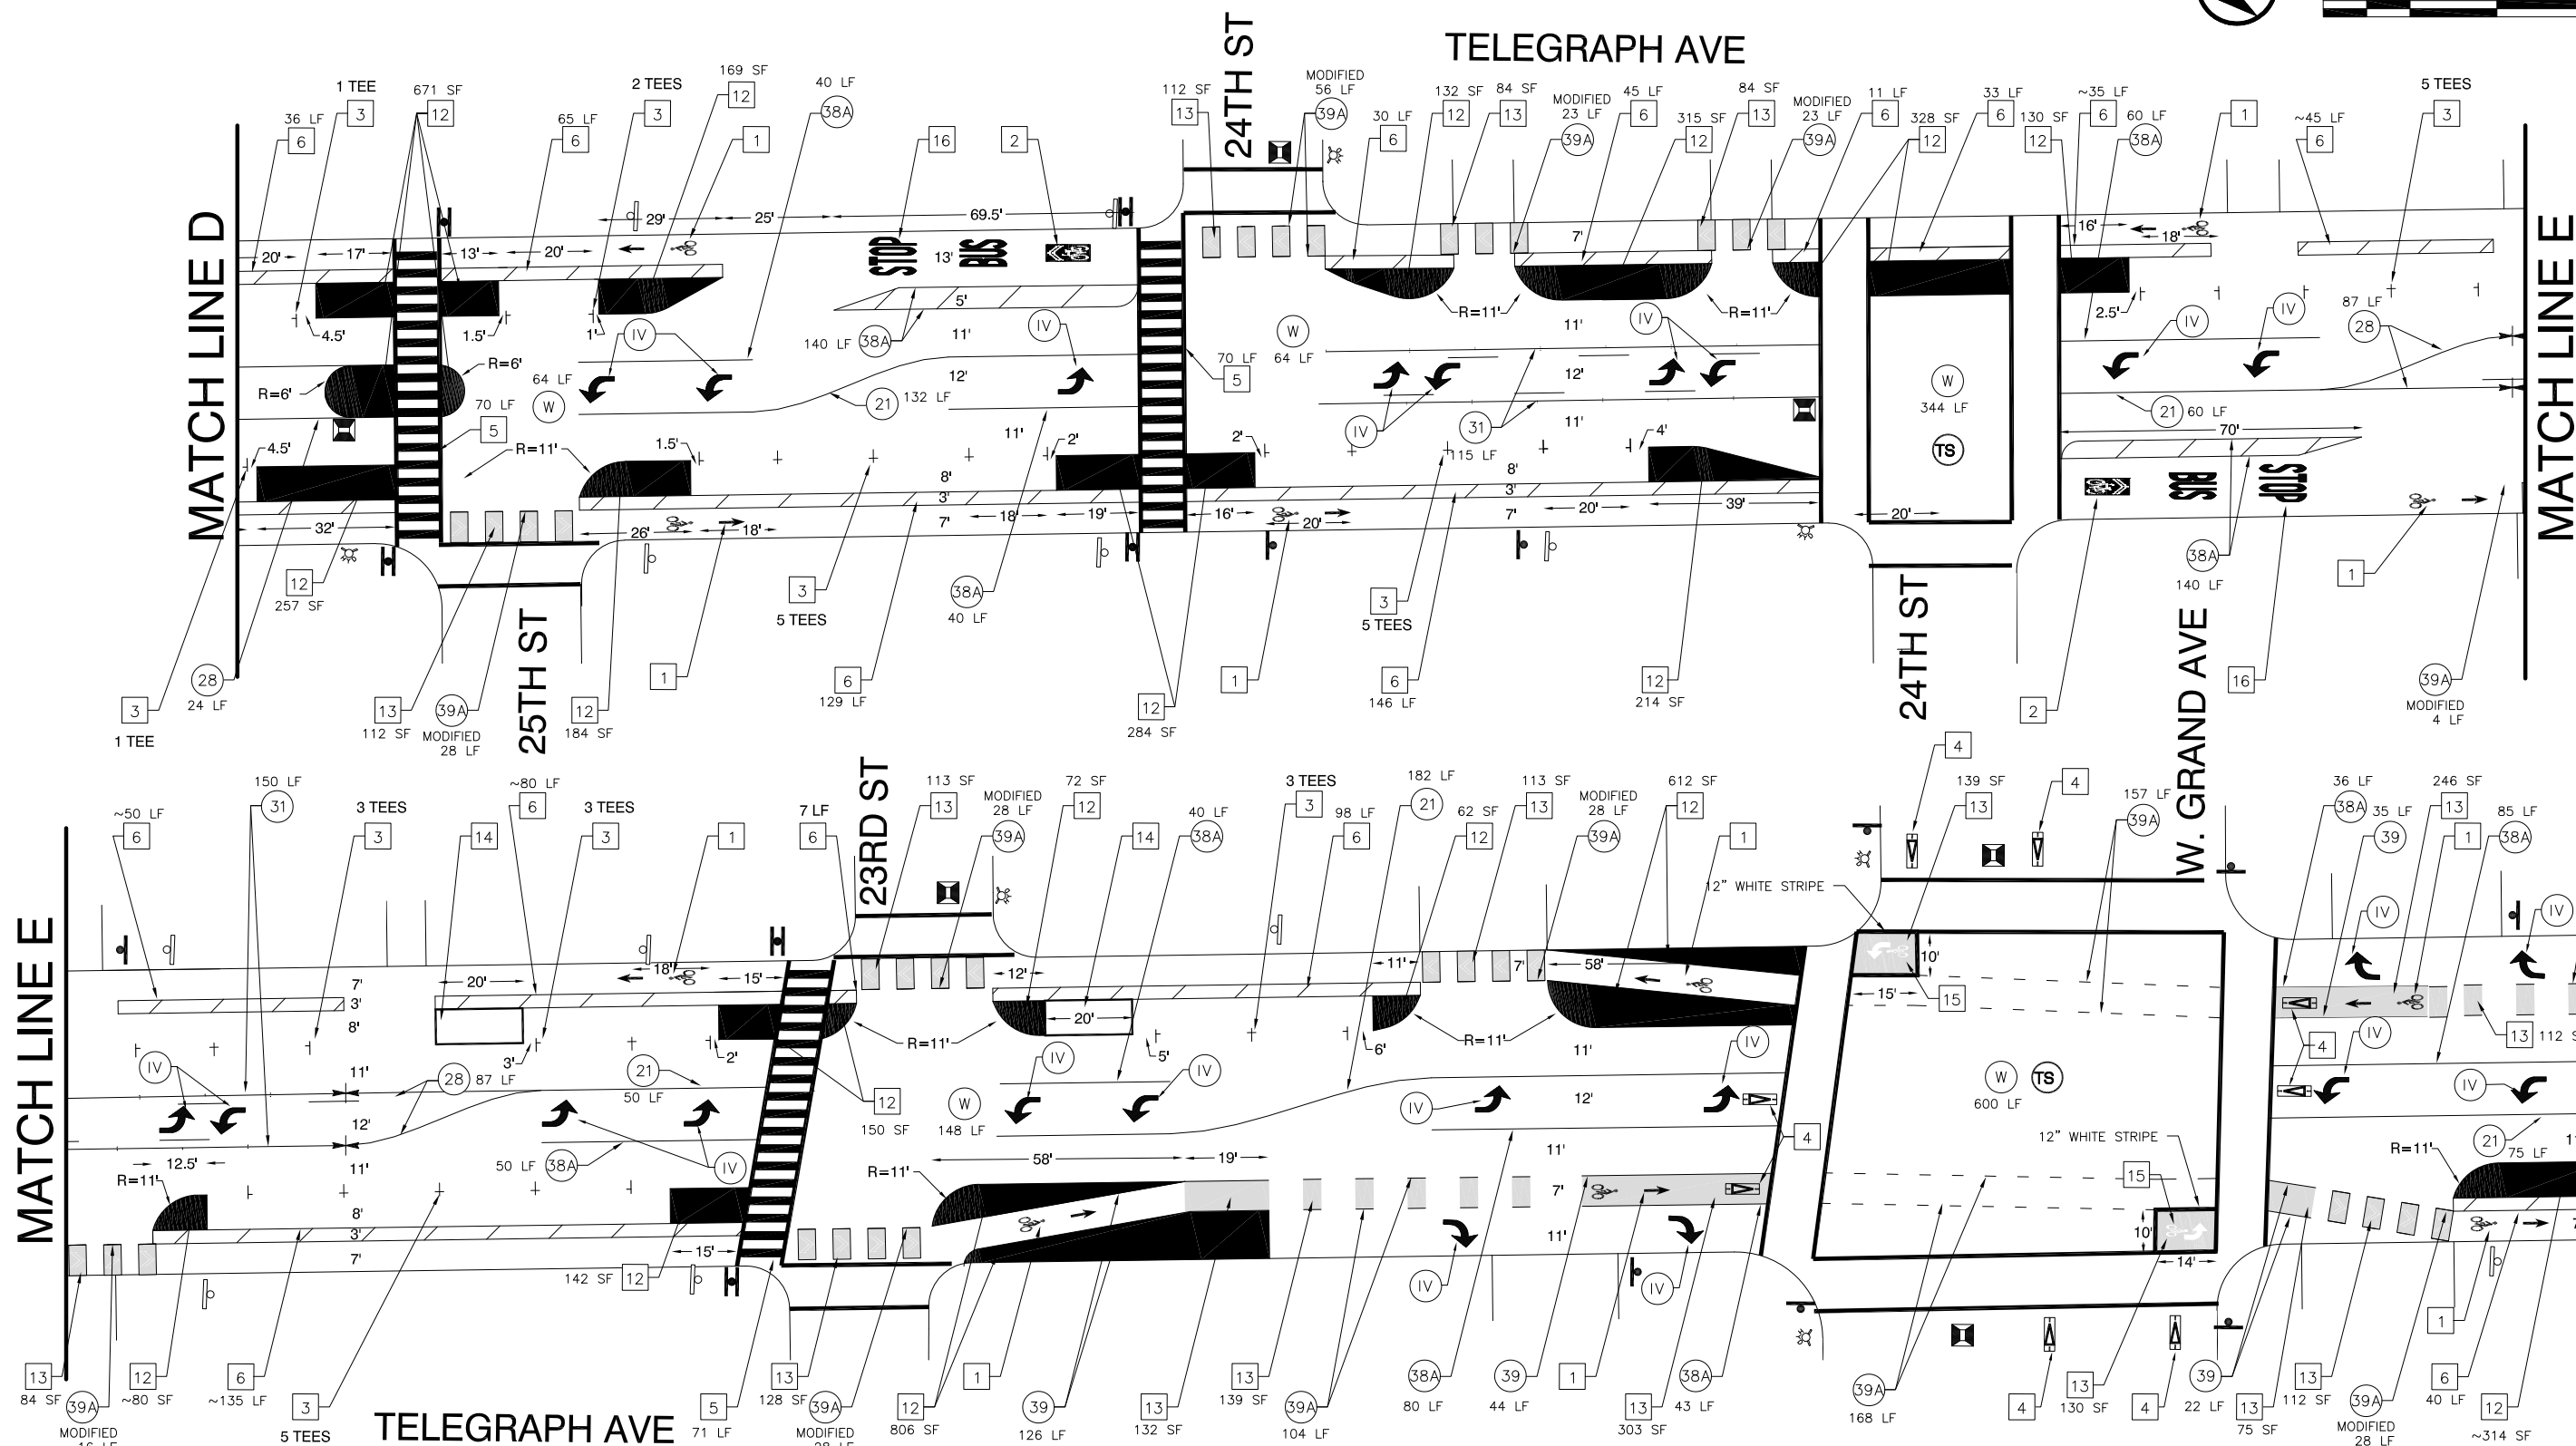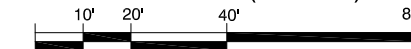CITY OF OAKLAND
OakDOT | Bicycle and Pedestrian Program
250 FRANK H. OGAWA PLAZA, SUITE 4344 • OAKLAND, CA 94612
(510) 238-3467 • FAX (510) 238-7415

**TELEGRAPH AVENUE
COMPLETE STREETS PROJECT
CITY OF OAKLAND**

FEHR & PEERS
100 Pringle Avenue Walnut Creek, CA 94596
Suite 600 (925) 930-7100

CHECKED BY	PC/MA
DESIGNED BY	RM/CN
DRAWN BY	LC/CW

No.	BY	DATE	REFERENCE


STRIPING PLAN
AS-BUILT
MAY 2016

PROJECT NO.
C369640
PR# 11

SCALE:
AS SHOWN
DATE:
Feb. 26, 2018


SHEET NO.
SS-4
4 OF 7

BROADWAY AVENUE TO GOLDEN GATE WAY BIKEPEDESTRIAN PROJECT CALBERT TUNNEL SETTLEMENT
 DRAWN BY: LC/CW
 CHECKED BY: RM/CN
 DATE: FEB 26 2018
 PLOTTED BY:

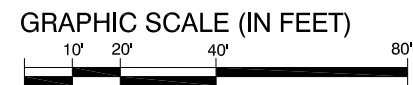

TELEGRAPH AVE

SEE SHEET SS-1 FOR CONSTRUCTION NOTES AND LEGEND

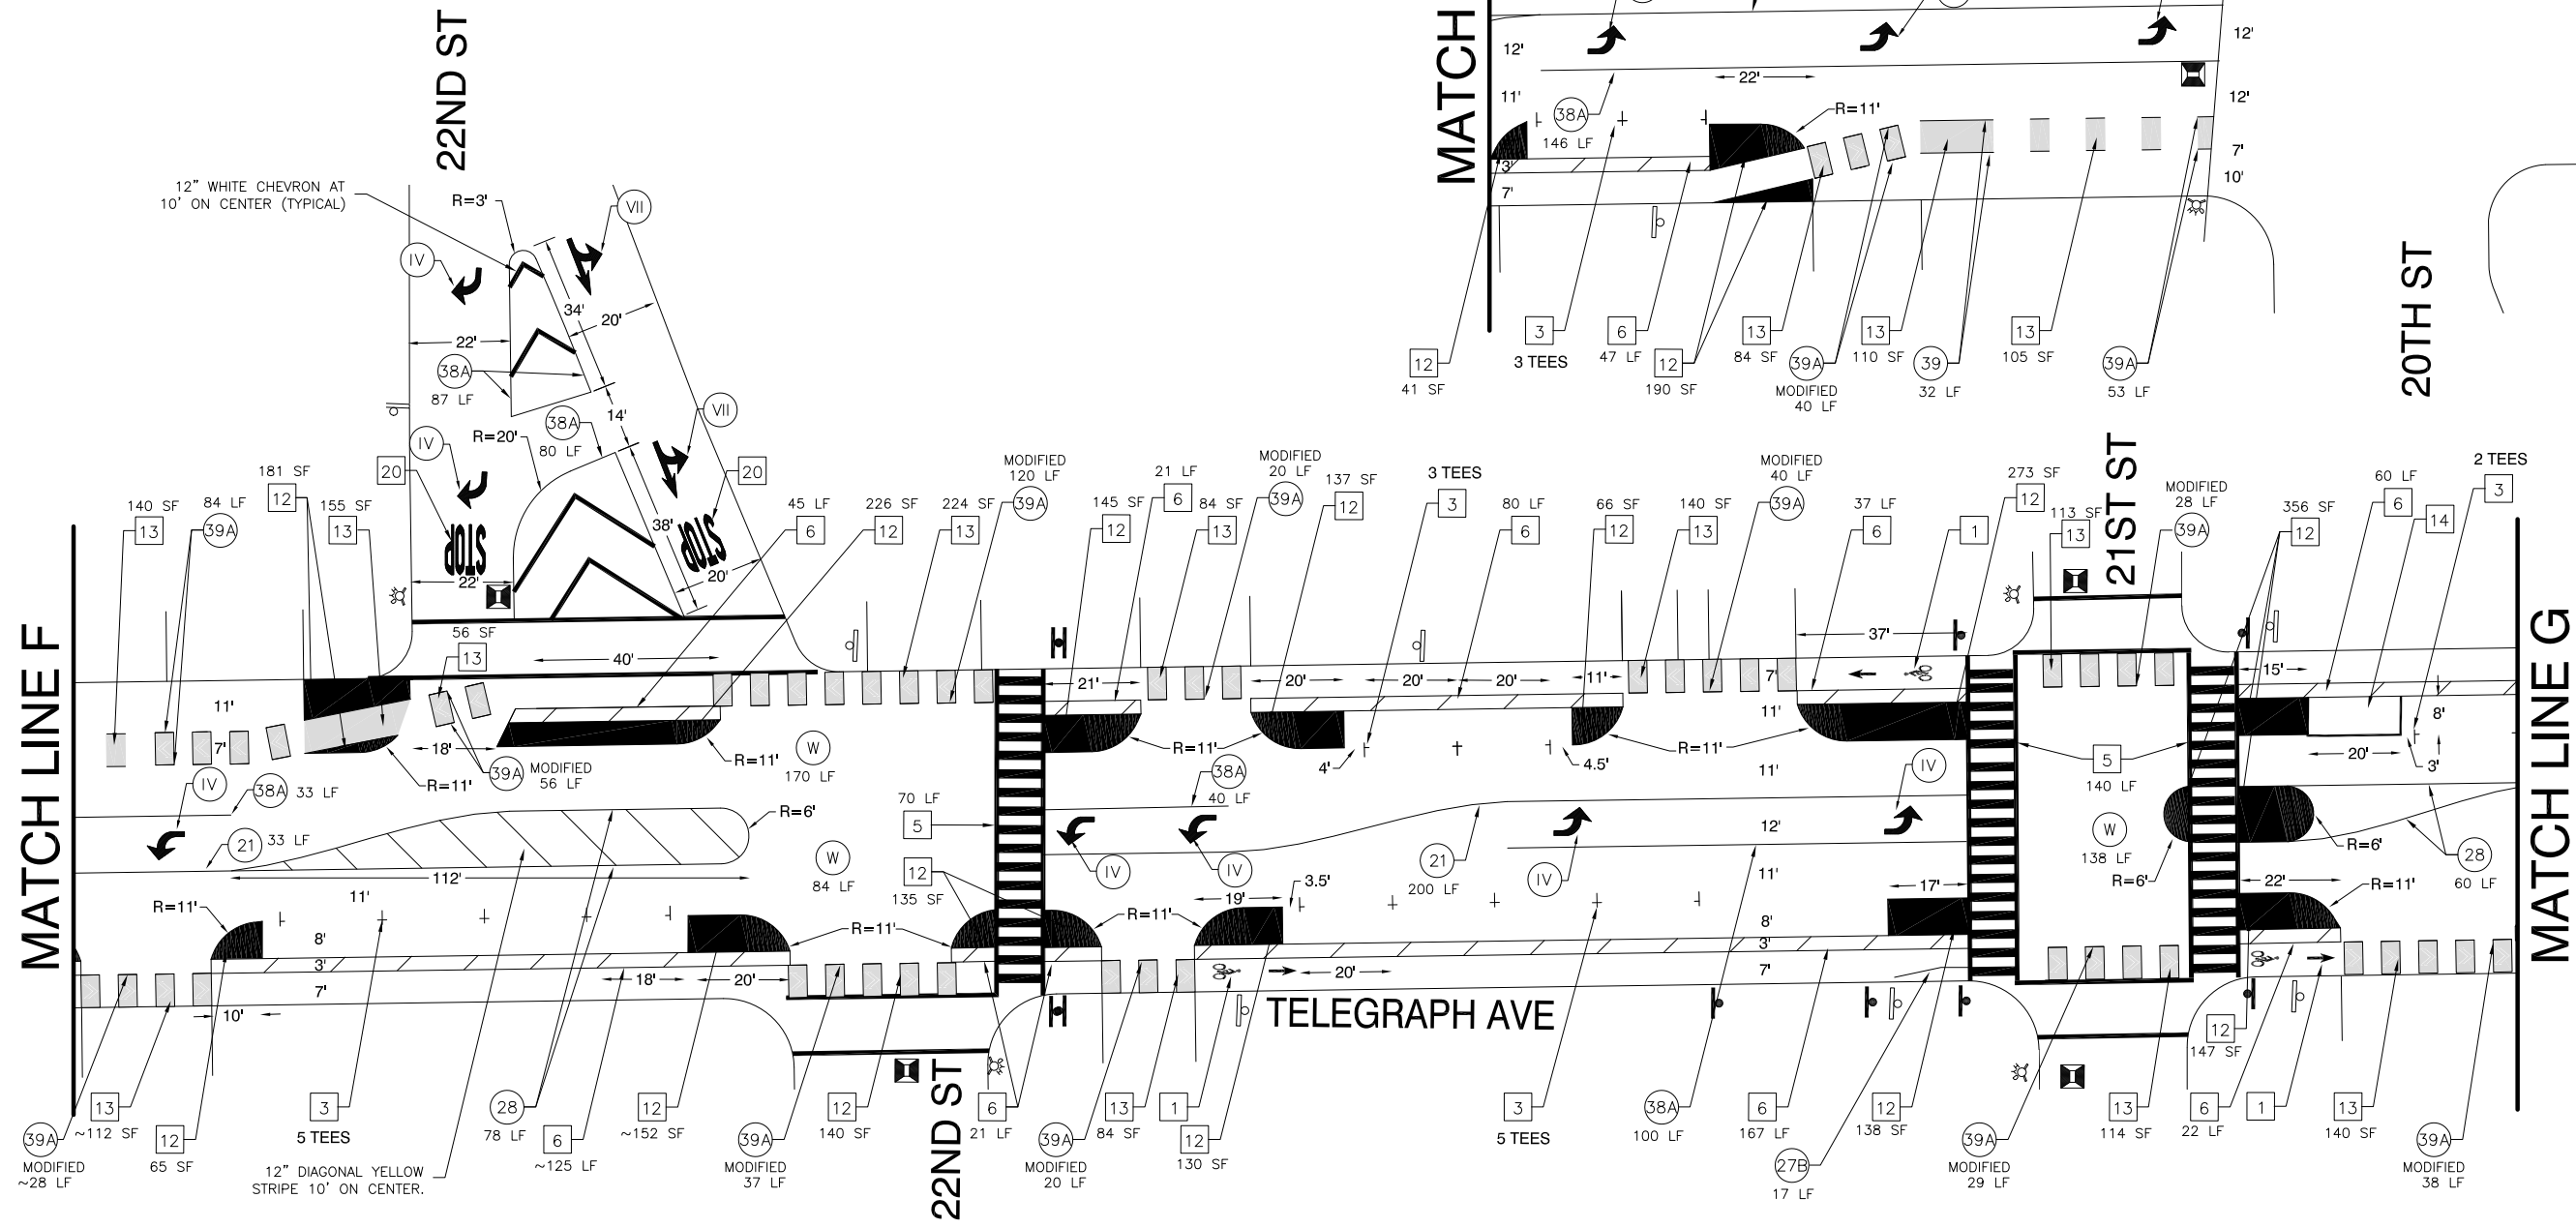

CITY OF OAKLAND
 OakDOT | Bicycle and Pedestrian Program
 250 FRANK H. OGAWA PLAZA, SUITE 4344 * OAKLAND, CA 94612
 (510) 238-3467 * FAX (510) 238-7415

**TELEGRAPH AVENUE
 COMPLETE STREETS PROJECT
 CITY OF OAKLAND**

FEHR & PEERS
 100 Pringle Avenue Walnut Creek, CA 94596
 Suite 600 (925) 930-7100

CHECKED BY	PC/MA
DESIGNED BY	RM/CN
DRAWN BY	LC/CW

No.	BY	DATE	REFERENCE

STRIPING PLAN
AS-BUILT
MAY 2016












PROJECT NO.
 C369640
 PR# 11



SCALE:
 AS SHOWN
DATE:
 Feb. 26, 2018

SHEET NO.
 SS-5
 5 OF 7

DRAWN BY: [Name] CHECKED BY: [Name] DESIGNED BY: [Name] PROJECT: BICYCLE AND PEDESTRIAN PROJECT - CALVERT TUNNEL SETTLEMENT
 FILE NAME: C:\Users\red\Program\Projects\TelegraphAve\0_Telegraph-29th-20th\SS1-Working\Does\CAD\3080-SS1-SS12-1.mxd
 PLOTTED BY: [Name]

SIGN LEGEND

-  R3-7
-  W11-2
-  W16-7P
-  R13A(CA)
-  R30(CA)
-  R30A(CA) MOD
-  R32(CA)
-  R3-1
-  R3-2
-  W74(CA)
-  SW50(CA)

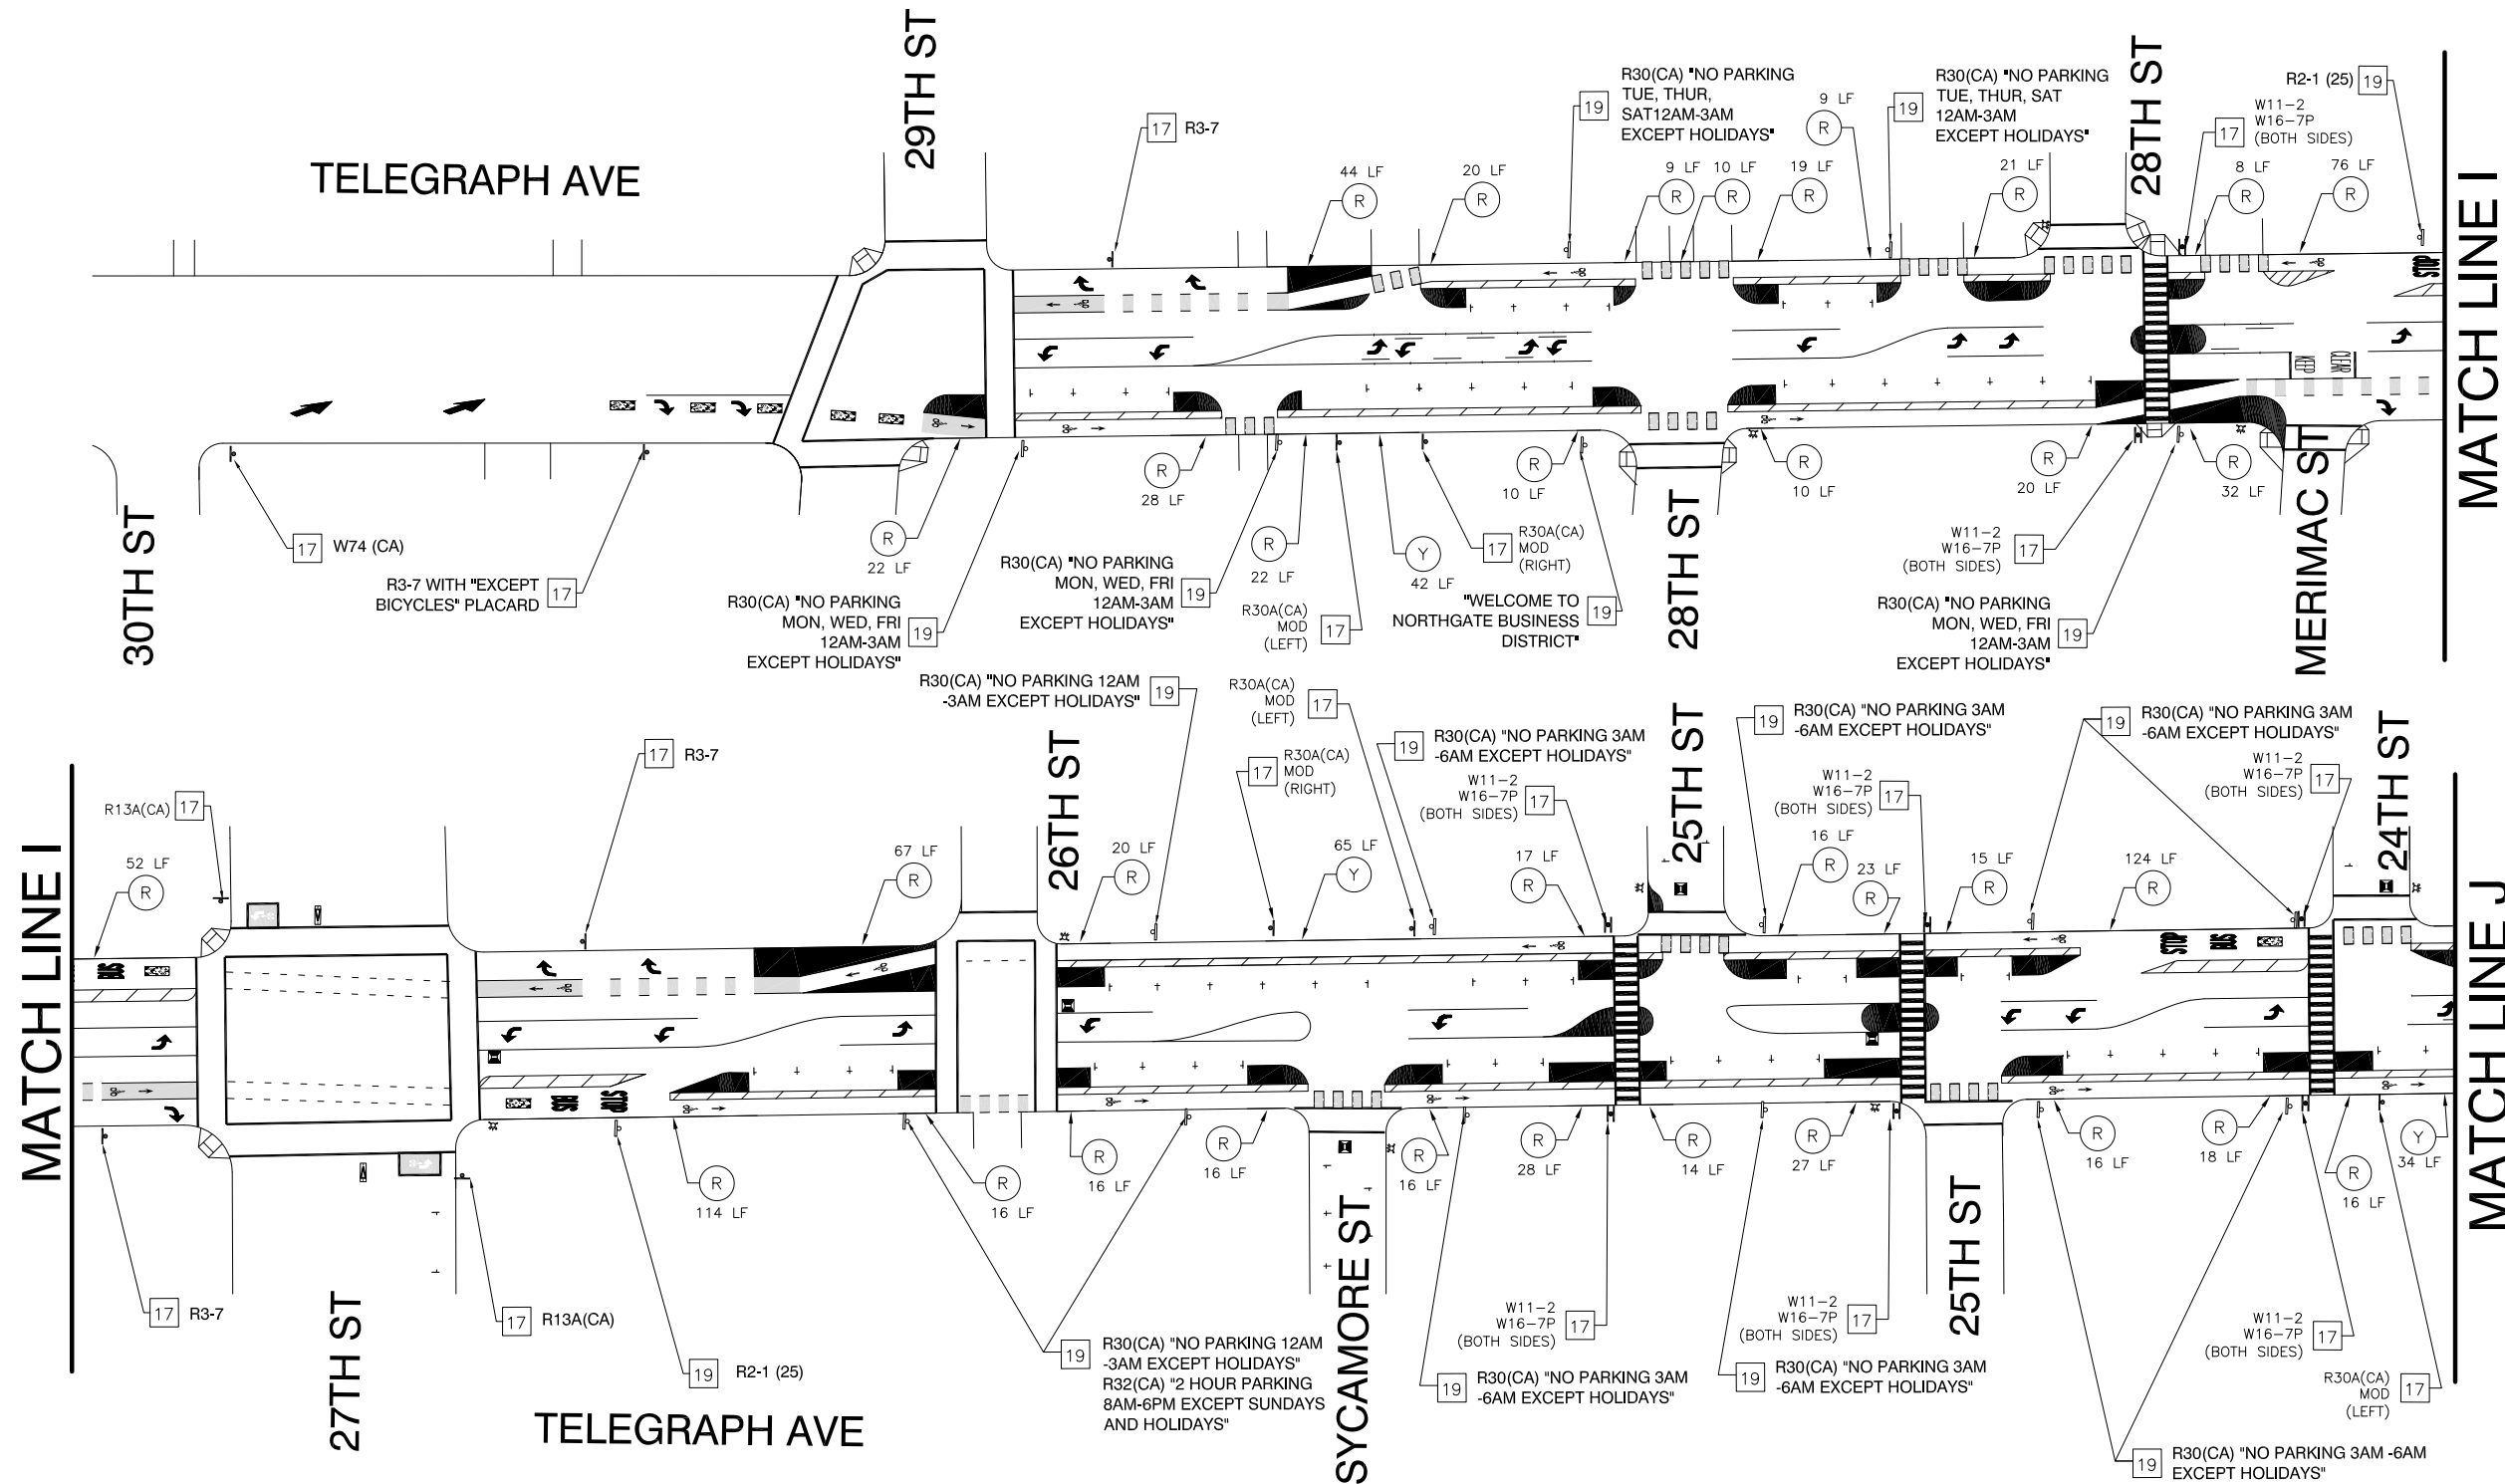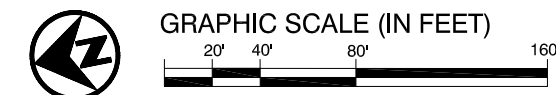

CITY OF OAKLAND
 OakDOT | Bicycle and Pedestrian Program
 250 FRANK H. OGAWA PLAZA, SUITE 4344 * OAKLAND, CA 94612
 (510) 238-3467 * FAX (510) 238-7415

TELEGRAPH AVENUE
 COMPLETE STREETS PROJECT
 CITY OF OAKLAND

FEHR & PEERS
 100 Pringle Avenue Walnut Creek, CA 94596
 Suite 600 (925) 930-7100

CHECKED BY	PC/MA
DESIGNED BY	RM/CN
DRAWN BY	LC/CW

No.	BY	DATE	REFERENCE

SIGNING PLAN
 AS-BUILT
 MAY 2016

PROJECT NO.
 C369640
 PR# 11












SCALE:
 AS SHOWN




DATE:
 Feb. 26, 2018

SHEET NO.
 SS-6
 6 OF 7

C:\Program Files\AutoCAD\Projects\Bicycle and Pedestrian Program\Telegraph Ave\0_Telegraph_29th-20th\SS-6_Signing\SS-6_Signing.dwg
 DRAWN BY: LC/CW
 CHECKED BY: PC/MA
 DESIGNED BY: RM/CN
 PLOTTED BY:

SIGN LEGEND

-  R3-7
-  W11-2
-  W16-7P
-  R13A(CA)
-  R30(CA)
-  R30A(CA) MOD
-  R32(CA)
-  R3-1
-  R3-2
-  W74(CA)
-  SW50(CA)

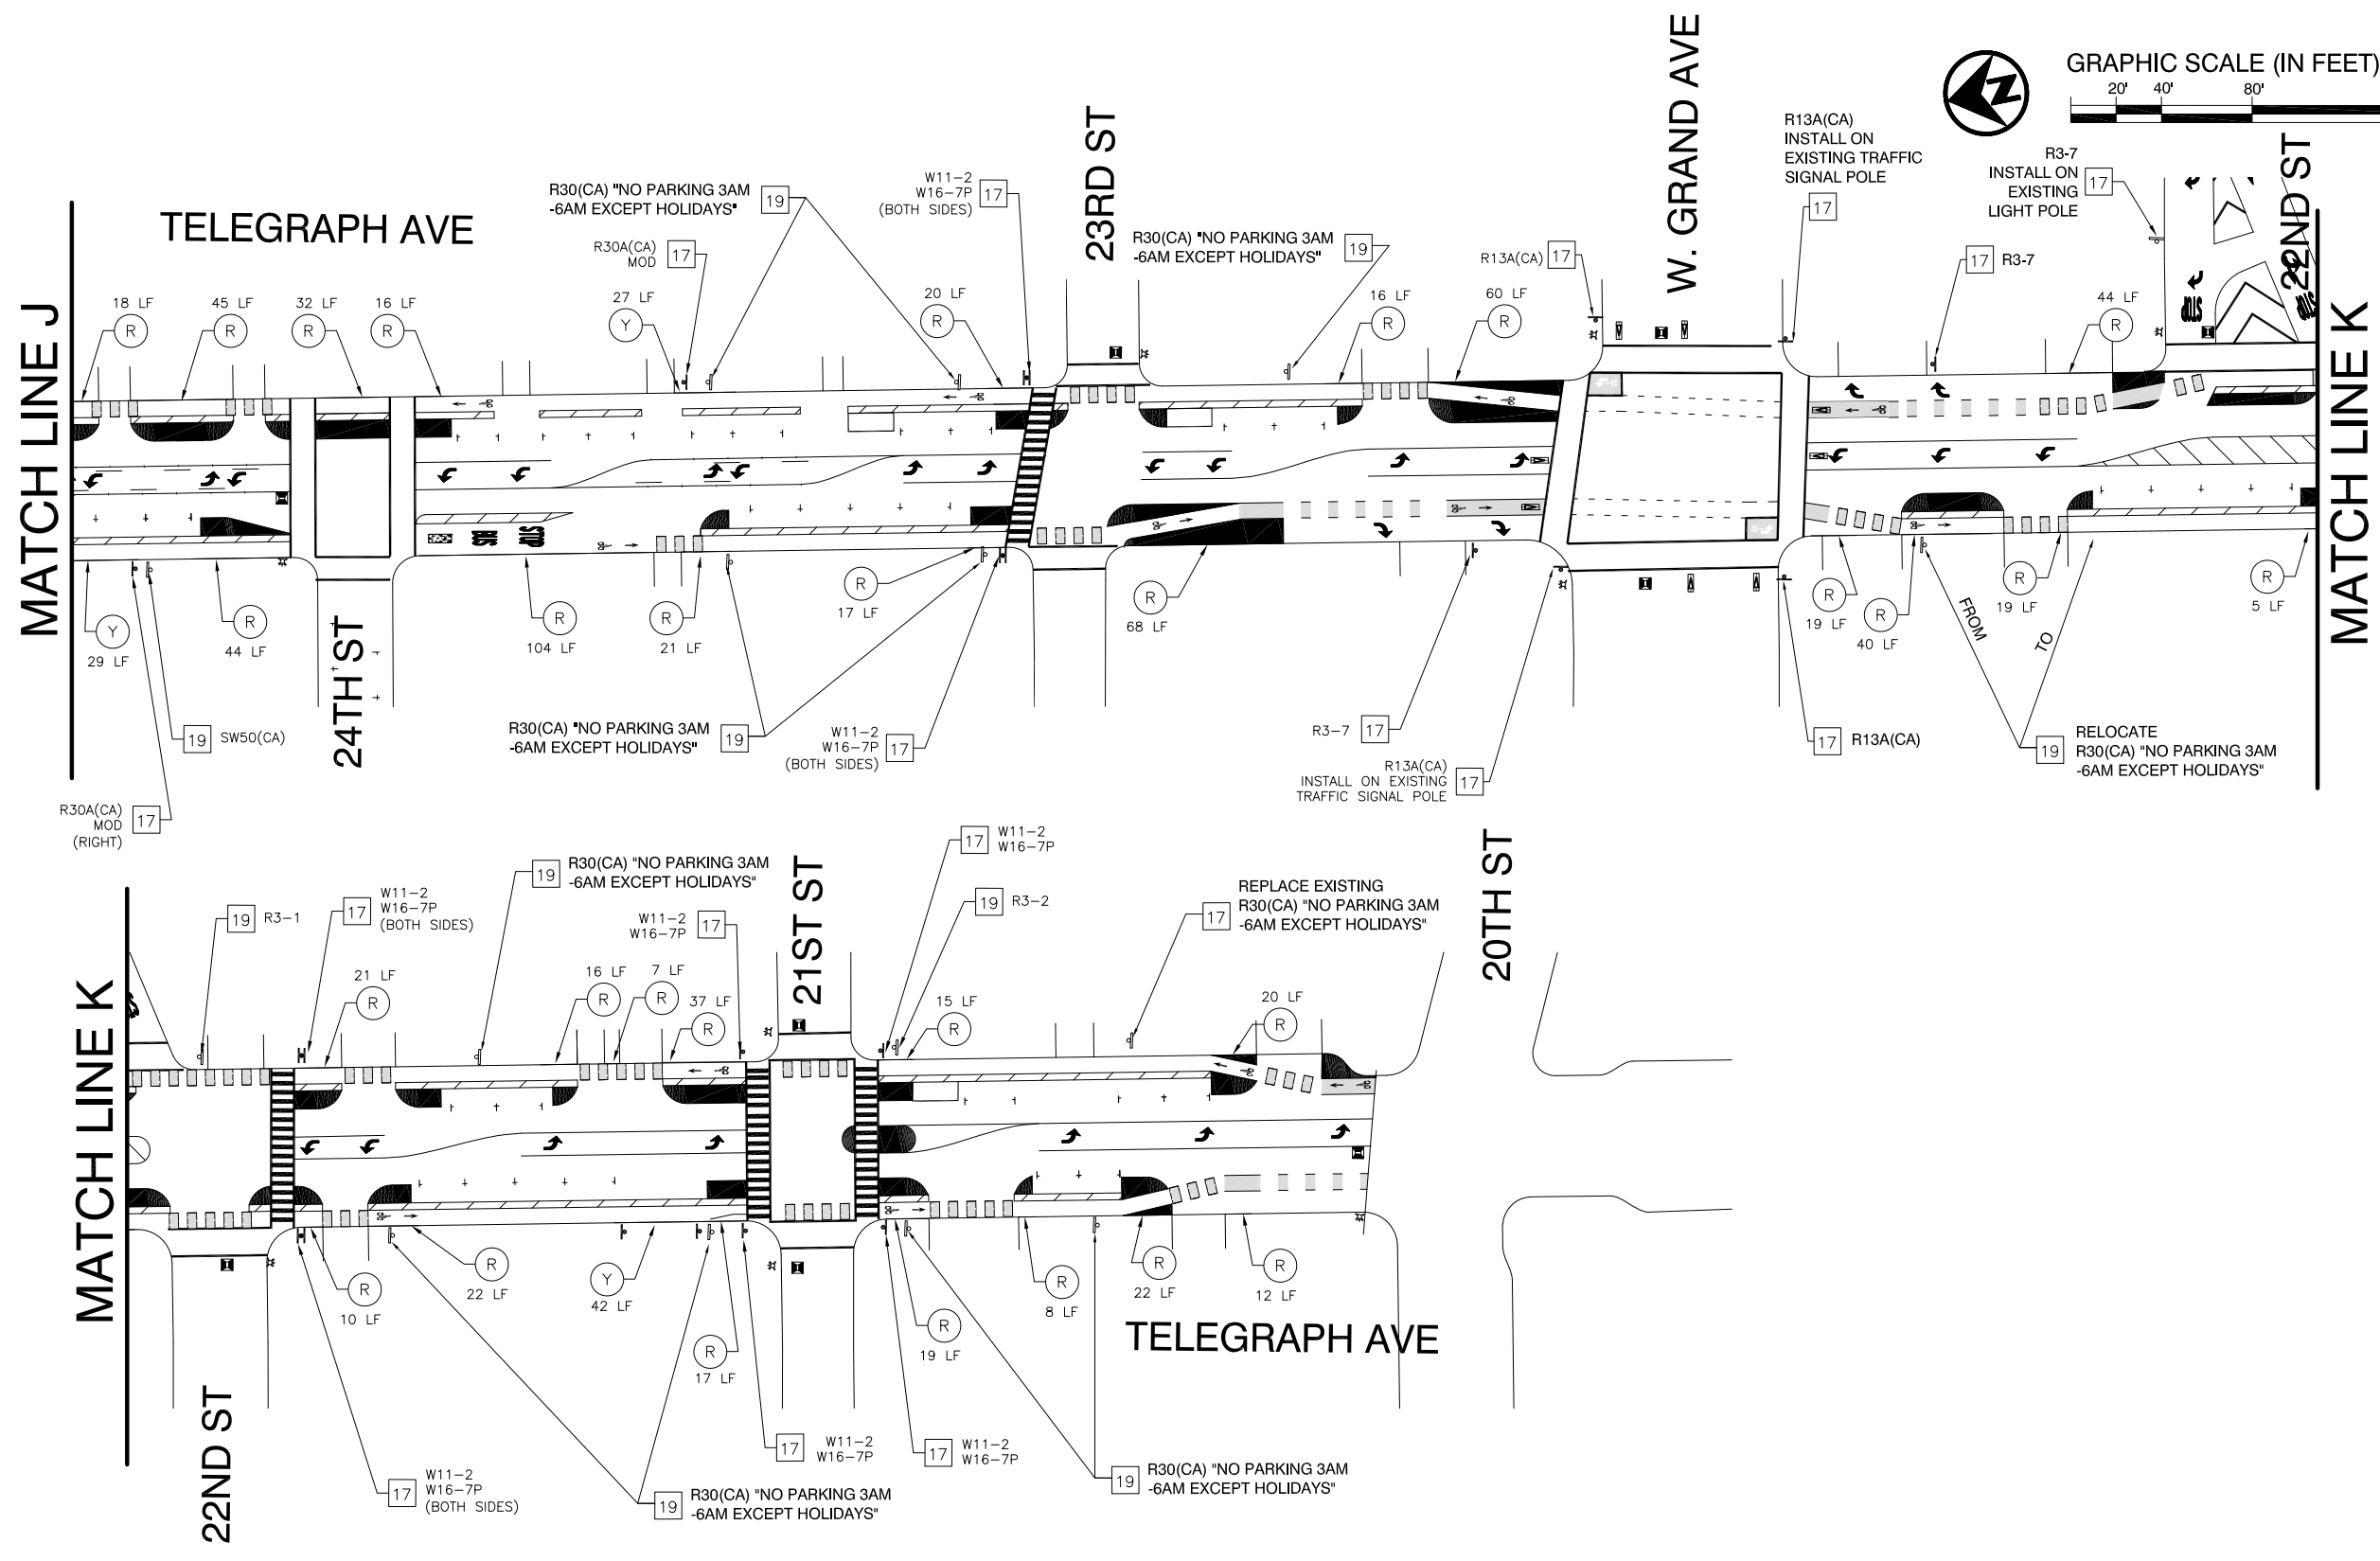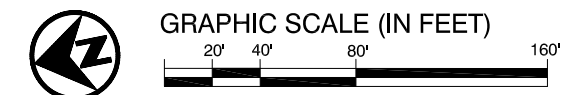CITY OF OAKLAND
 OakDOT | Bicycle and Pedestrian Program
 250 FRANK H. OGAWA PLAZA, SUITE 4344 * OAKLAND, CA 94612
 (510) 238-3467 * FAX (510) 238-7415

**TELEGRAPH AVENUE
 COMPLETE STREETS PROJECT
 CITY OF OAKLAND**

FEHR & PEERS
 100 Pringle Avenue Walnut Creek, CA 94596
 Suite 600 (925) 930-7100


CHECKED BY	PC/MA	No.	BY	DATE	REFERENCE
DESIGNED BY	RM/CN				
DRAWN BY	LC/CW				

No.	BY	DATE	REFERENCE

**SIGNING PLAN
 AS-BUILT
 MAY 2016**


PROJECT NO. C369640 PR# 11	
SCALE: AS SHOWN DATE: Feb. 26, 2018	SHEET NO. SS-7 7 OF 7

DRAWING NAME: C:\p\proj\Program\Projects\Bikeways-stripping\TelegraphAve\0_Telegraph_29th-20th\SS-7\Working Docs\CADD\3080-SS-7_SSTL_Final.dwg
 DATE PLOTTED: 2/26/2018 10:54:11 AM
 PLOTTED BY: Elnora

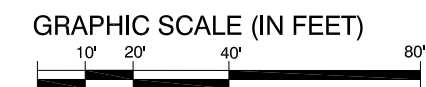


LEGEND (PM-1 TO PM-6)

- (EX) EXISTING PARKING METER TO REMAIN
- (RL) RELOCATED PARKING METER
- (N) NEW PARKING METER

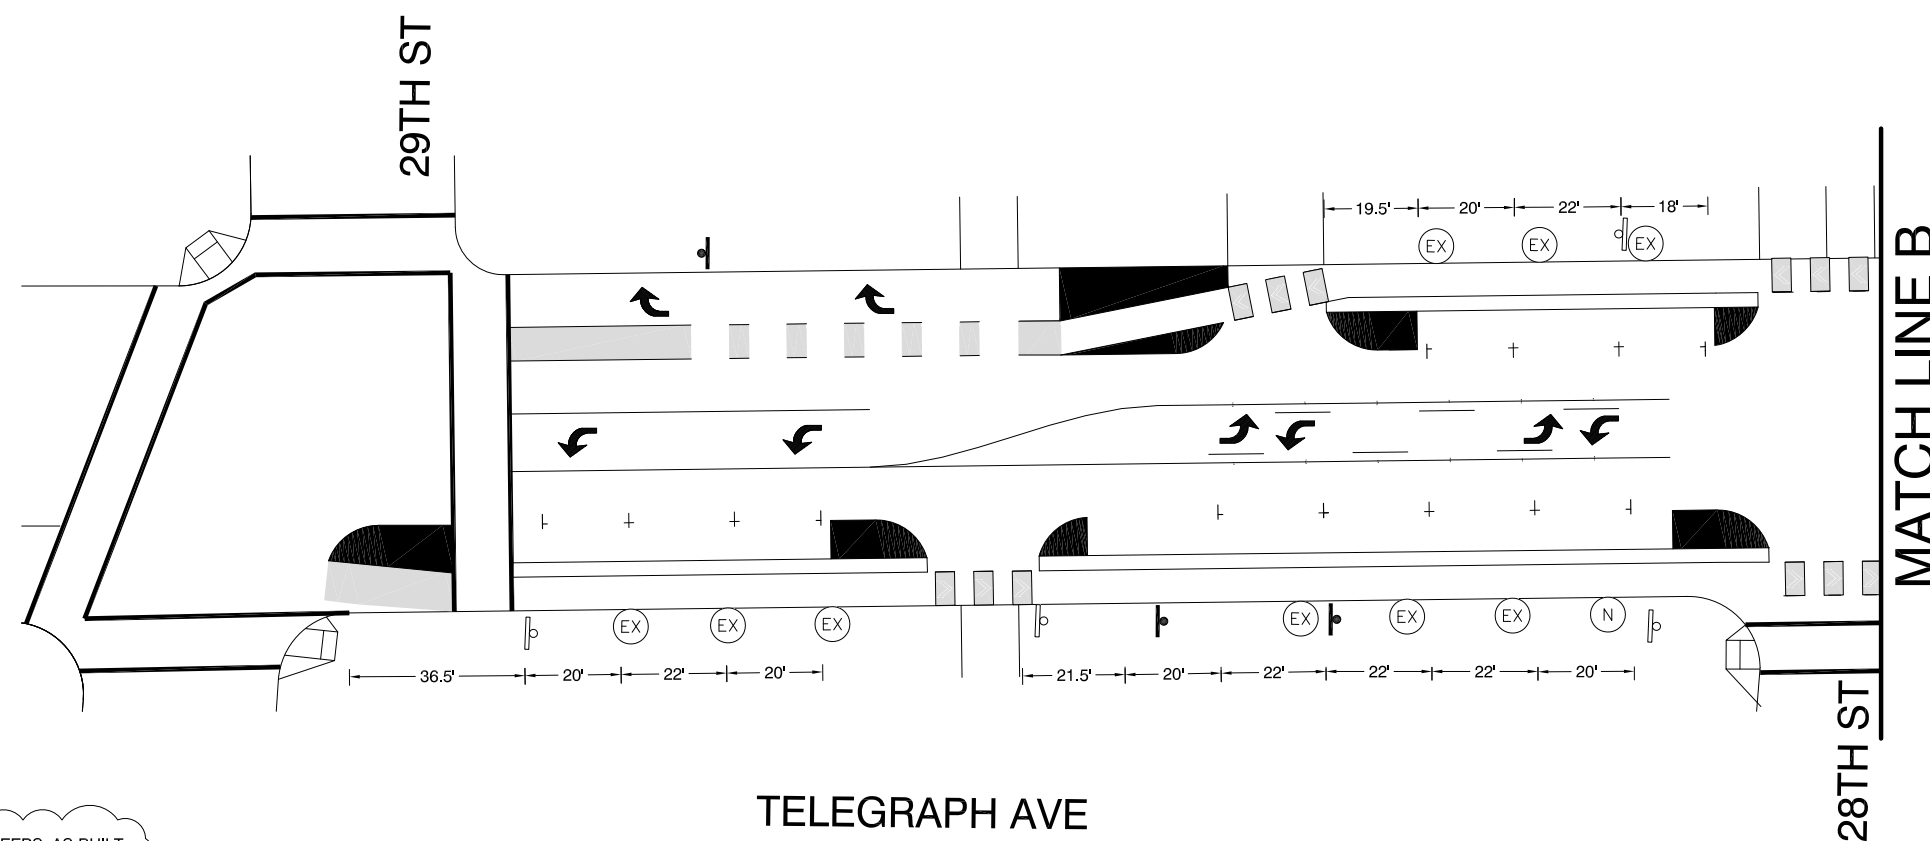

AS-BUILT NOTE: ORIGINAL PLANS BY FEHR & PEERS. AS-BUILT PLANS BY THE CITY OF OAKLAND'S BICYCLE & PEDESTRIAN PROGRAM.

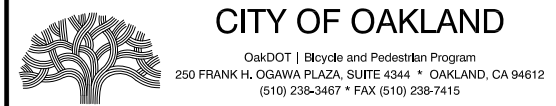

TELEGRAPH AVENUE
COMPLETE STREETS PROJECT
CITY OF OAKLAND

FEHR & PEERS
100 Pringle Avenue Walnut Creek, CA 94596
Suite 600 (925) 930-7100

CHECKED BY	PC/MA
DESIGNED BY	RM/CN
DRAWN BY	LC/CW

No.	BY	DATE	REFERENCE




PARKING METER PLAN
AS-BUILT
MAY 2016

PROJECT NO. CITY OF OAKLAND WORK ORDER	
SCALE: AS SHOWN DATE: Feb. 26, 2018	SHEET NO. PM-1 1 OF 6

PROJECT NO. 2016-0001
 SHEET NO. PM-1
 DATE: Feb. 26, 2018
 DRAWN BY: LC/CW
 CHECKED BY: PC/MA
 DESIGNED BY: RM/CN
 PROJECT: TELEGRAPH AVENUE TO GOLDEN GATE WAY BIKE/PEDESTRIAN PROJECT - CALDECOTT TUNNEL SETTLEMENT
 FILE: C:\Users\lcastro\Documents\Projects\Bike-Ped\Program\Projects\TelegraphAve\O_o_Telegraph_29th-20th\Working Docs\CADD\3080-SS1_SSTL_final.dwg
 PLOTTED BY: Elsie

LEGEND (PM-1 TO PM-6)

- (EX) EXISTING PARKING METER TO REMAIN
- (RL) RELOCATED PARKING METER
- (N) NEW PARKING METER

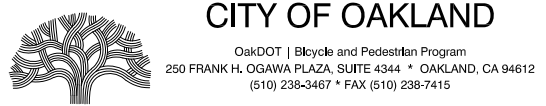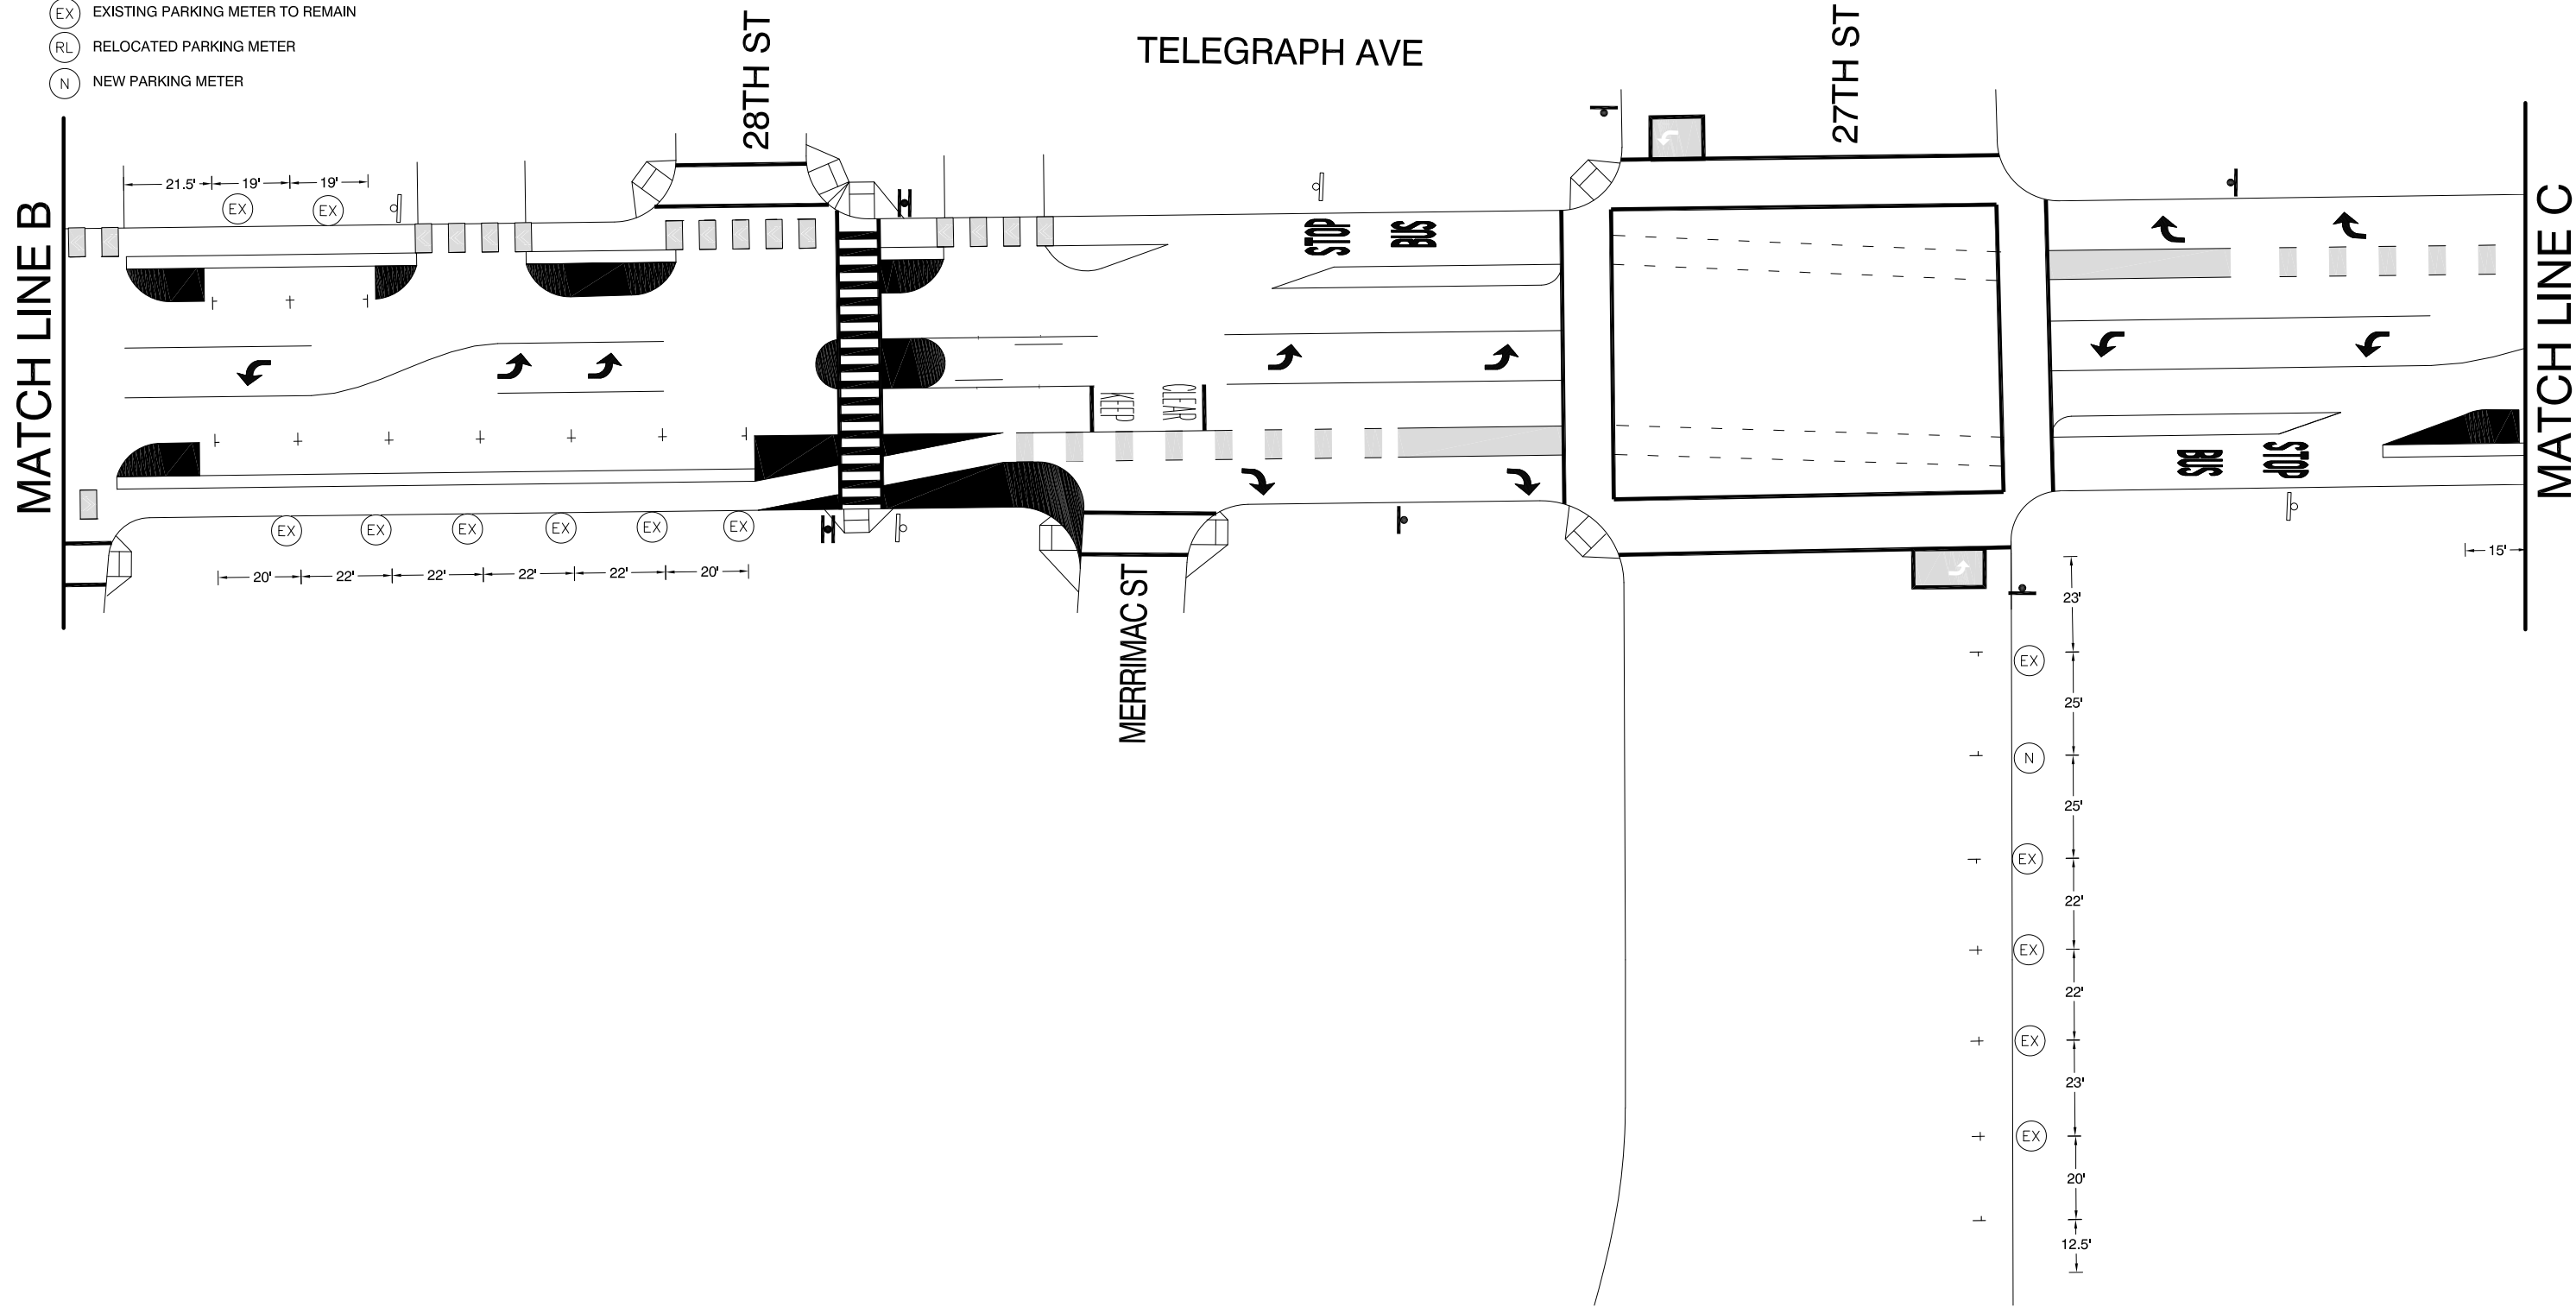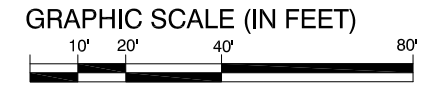

TELEGRAPH AVENUE
COMPLETE STREETS PROJECT
CITY OF OAKLAND



CHECKED BY	PC/MA
DESIGNED BY	RM/CN
DRAWN BY	LC/CW

No.	BY	DATE	REFERENCE

PARKING METER PLAN

AS-BUILT
MAY 2016

PROJECT NO. CITY OF OAKLAND WORK ORDER	
SCALE: AS SHOWN DATE: Feb. 26, 2018	SHEET NO. PM-2 2 OF 6

DRAWN BY: LC/CW
 CHECKED BY: RM/CN
 DATE: Feb. 26, 2018
 PROJECT: TELEGRAPH AVENUE TO GOLDEN GATE WAY BIKEPEDESTRIAN PROJECT - CALDECOTT TUNNEL SETTLEMENT
 FILE: \\cadd\3060-SS1_SSTL_final.dwg

CONSTRUCTION NOTES



- 1 INSTALL NEW SIGN
- 2 EXISTING SIGN TO REMAIN

LEGEND (PM-1 TO PM-6)

- (EX) EXISTING PARKING METER TO REMAIN
- (RL) RELOCATED PARKING METER
- (N) NEW PARKING METER

SIGN LEGEND

-  R30(CA)
-  R30A(CA) MOD

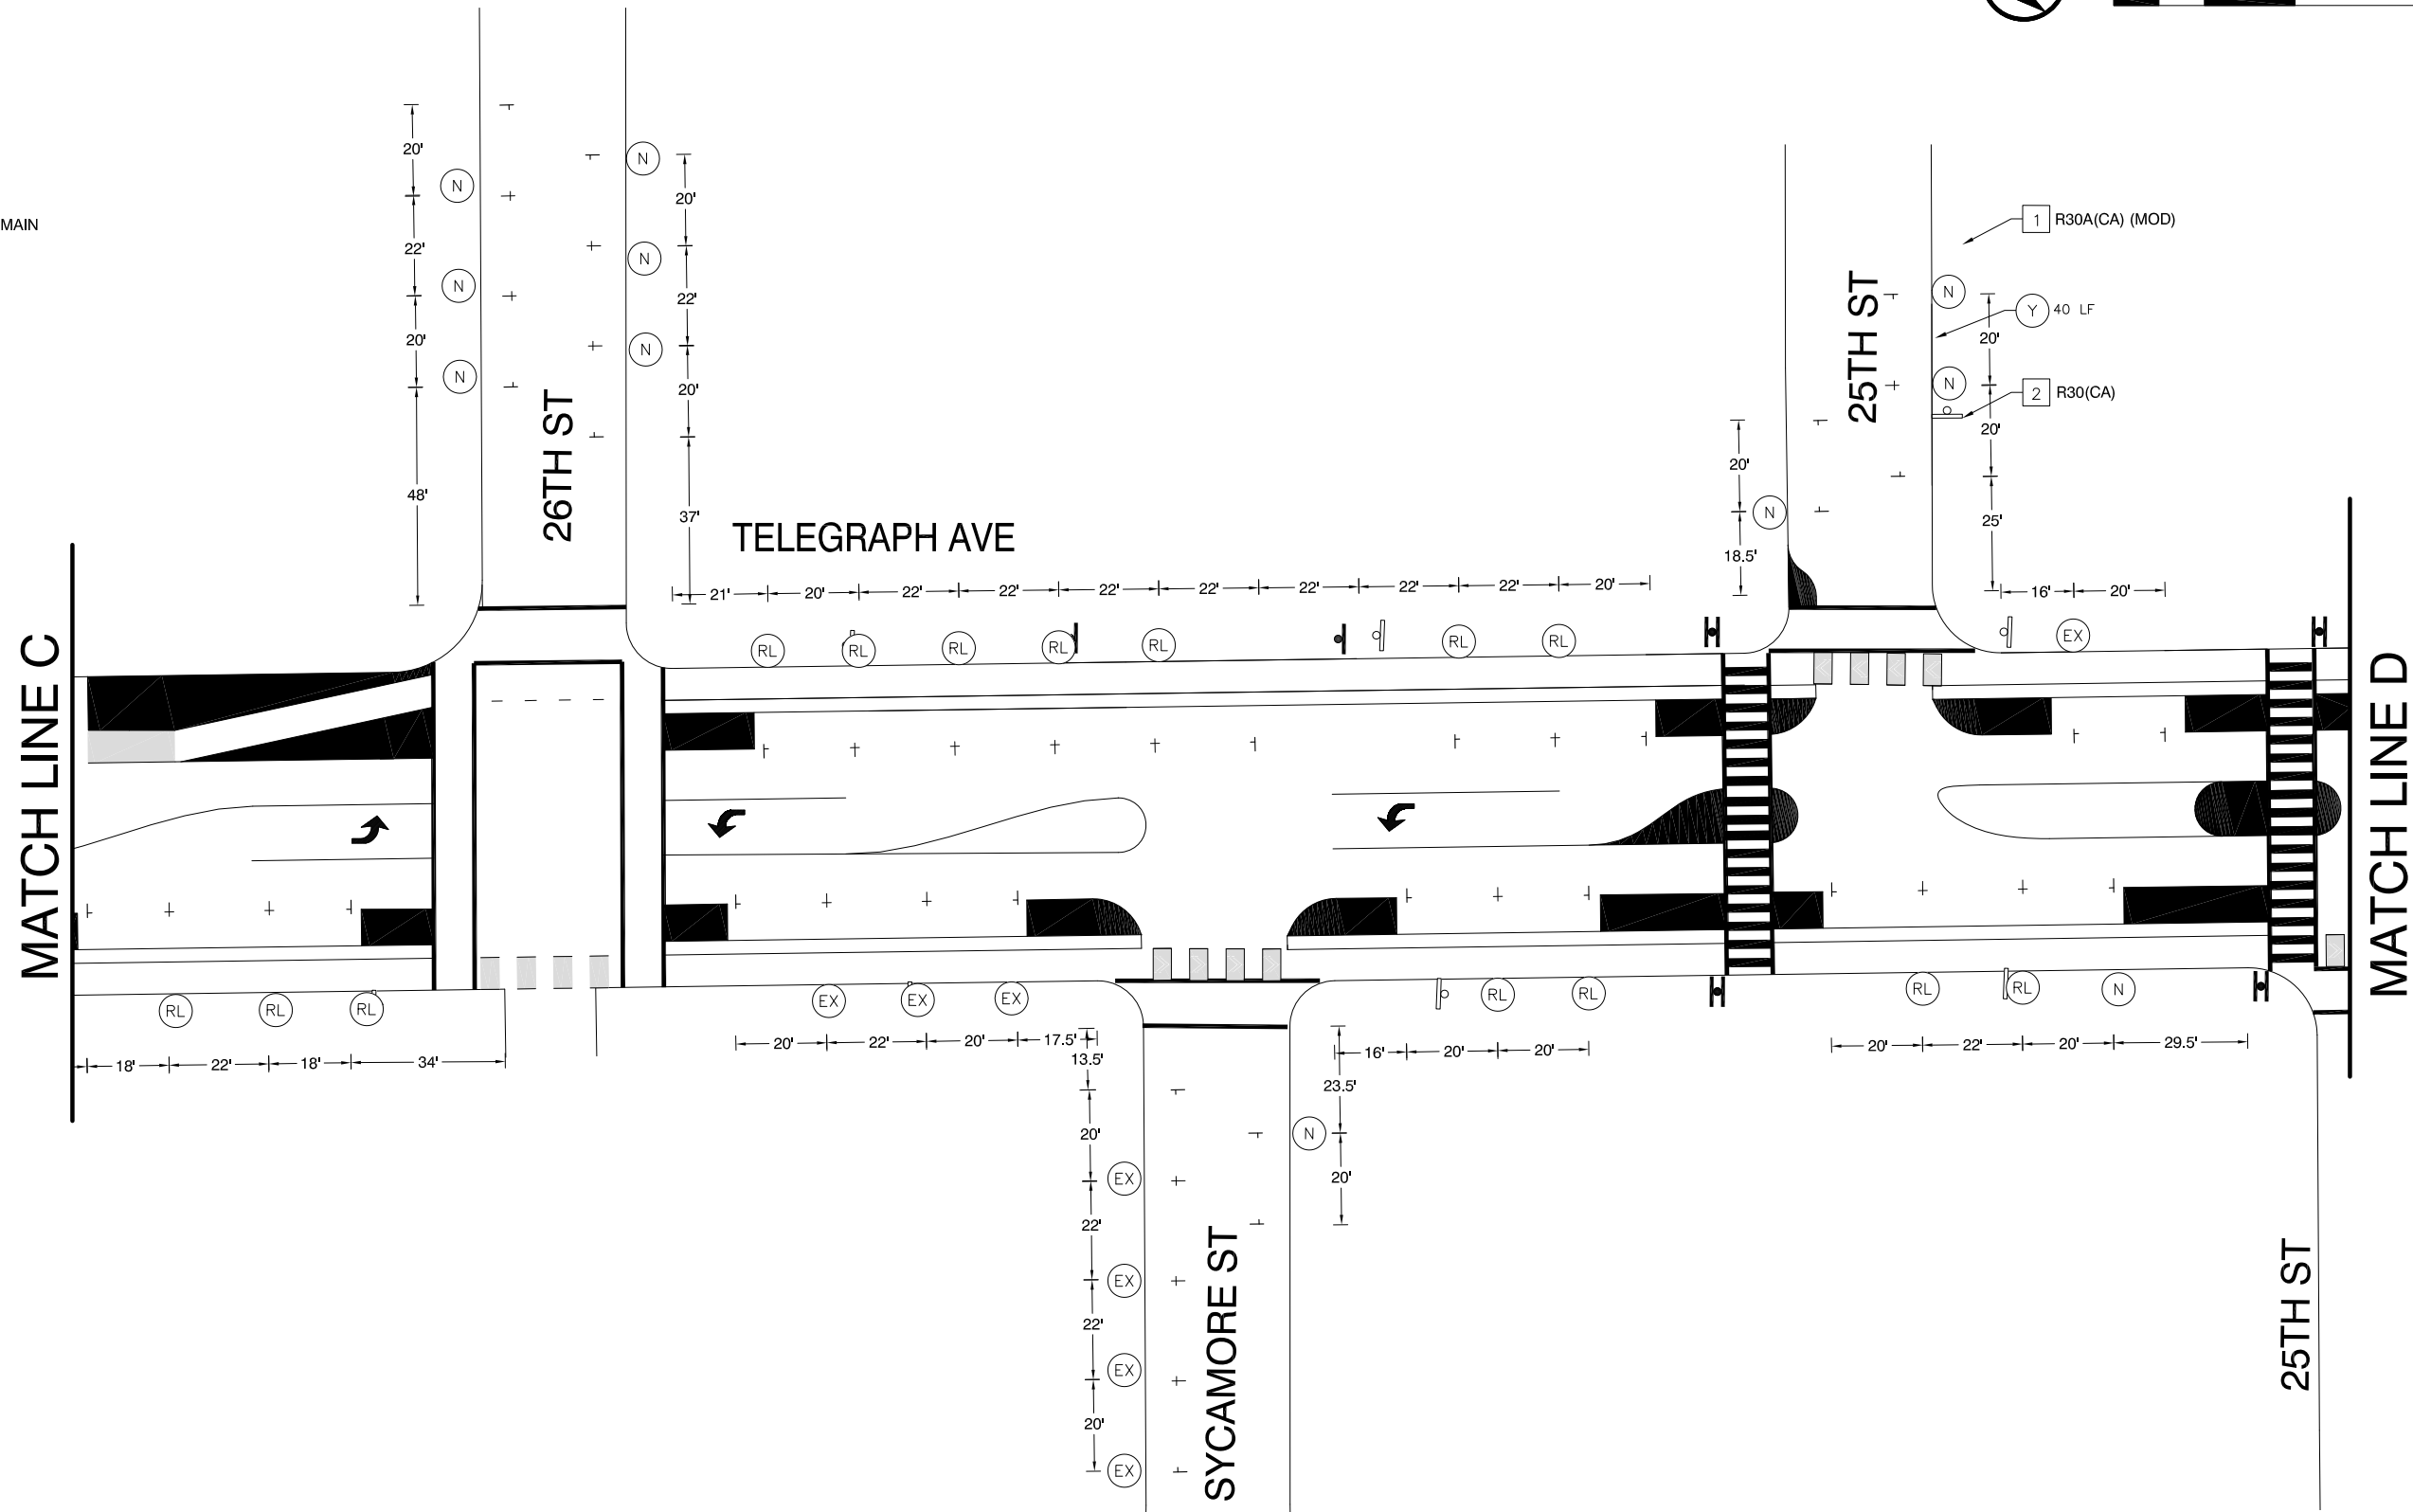CITY OF OAKLAND
 OakDOT | Bicycle and Pedestrian Program
 250 FRANK H. OGAWA PLAZA, SUITE 4344 * OAKLAND, CA 94612
 (510) 238-3467 * FAX (510) 238-7415

**TELEGRAPH AVENUE
 COMPLETE STREETS PROJECT
 CITY OF OAKLAND**

FEHR & PEERS
 100 Pringle Avenue Walnut Creek, CA 94596
 Suite 600 (925) 930-7100

No.	BY	DATE	REFERENCE

CHECKED BY: PC/MA
 DESIGNED BY: RM/CN
 DRAWN BY: LC/CW

No.	BY	DATE	REFERENCE

PARKING METER PLAN

**AS-BUILT
 MAY 2016**

**PROJECT NO.
 CITY OF OAKLAND
 WORK ORDER**

SCALE:
 AS SHOWN
 DATE:
 Feb. 26, 2018

SHEET NO.
PM-3
 3 OF 6

\Program\Projects\Brewery-stripping\TelegraphAve\0_Telegraph_29th-20th\Working Docs\CADD\3060-SS1_SST2_Final.dwg
 Date: 02/26/16
 Plotted By: Elsie


CONSTRUCTION NOTES

1 INSTALL NEW SIGN



LEGEND (PM-1 TO PM-6)

- (EX) EXISTING PARKING METER TO REMAIN
- (RL) RELOCATED PARKING METER
- (N) NEW PARKING METER

SIGN LEGEND

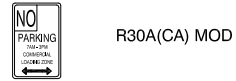

GRAPHIC SCALE (IN FEET)

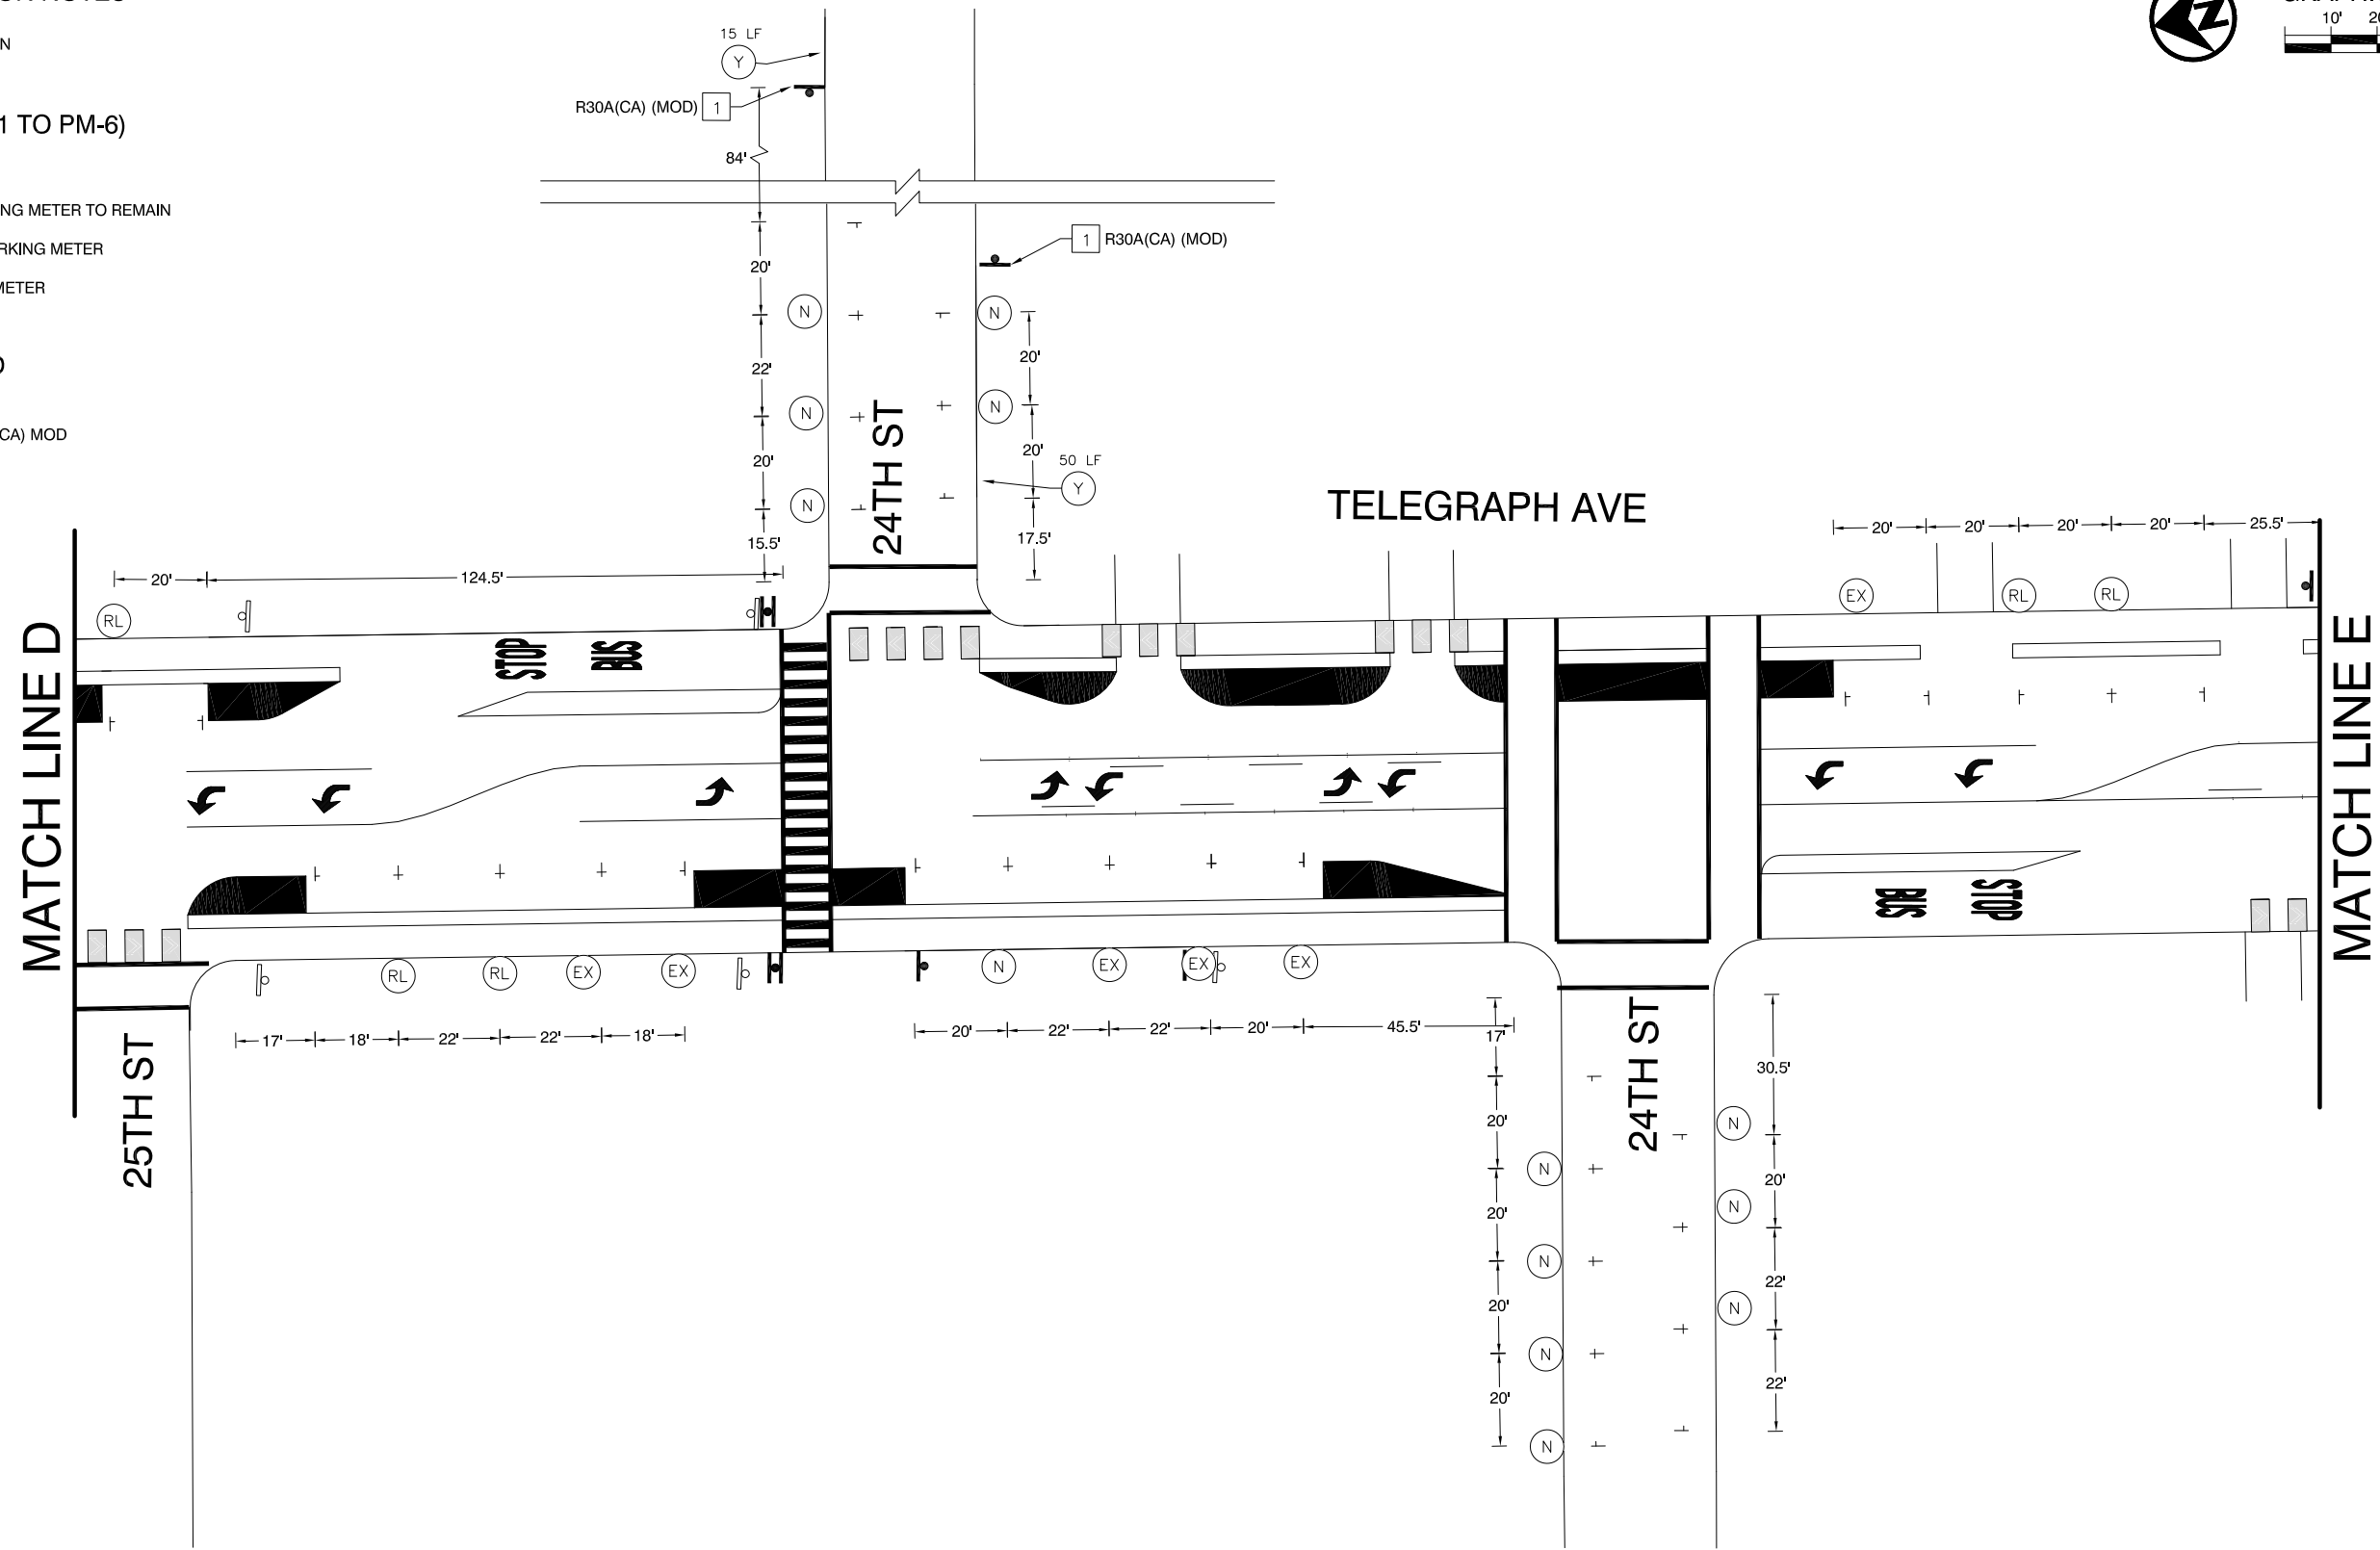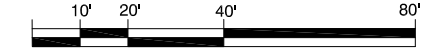

CITY OF OAKLAND
 OakDOT | Bicycle and Pedestrian Program
 250 FRANK H. OGAWA PLAZA, SUITE 4344 * OAKLAND, CA 94612
 (510) 238-3467 * FAX (510) 238-7415

TELEGRAPH AVENUE
 COMPLETE STREETS PROJECT
 CITY OF OAKLAND

FEHR PEERS
 100 Pringle Avenue Walnut Creek, CA 94596
 Suite 600 (925) 930-7100

Checked By	PC/MA
Designed By	RM/CN
Drawn By	LC/CW

No.	BY	DATE	REFERENCE

PARKING METER PLAN
 AS-BUILT
 MAY 2016

PROJECT NO.
 CITY OF OAKLAND
 WORK ORDER



SCALE:
 AS SHOWN
 DATE:
 Feb. 26, 2018

SHEET NO.
PM-4
 4 OF 6

C:\Users\jped\OneDrive\Documents\Projects\Bicycle and Pedestrian Program\Telegraph Ave\0_Telegraph_29th-30th\SS1_SST2_Final.dwg
 DRAWN BY: LC/CW
 CHECKED BY: PC/MA
 DESIGNED BY: RM/CN
 PLOTTED BY:

LEGEND (PM-1 TO PM-6)

- (EX) EXISTING PARKING METER TO REMAIN
- (RL) RELOCATED PARKING METER
- (N) NEW PARKING METER

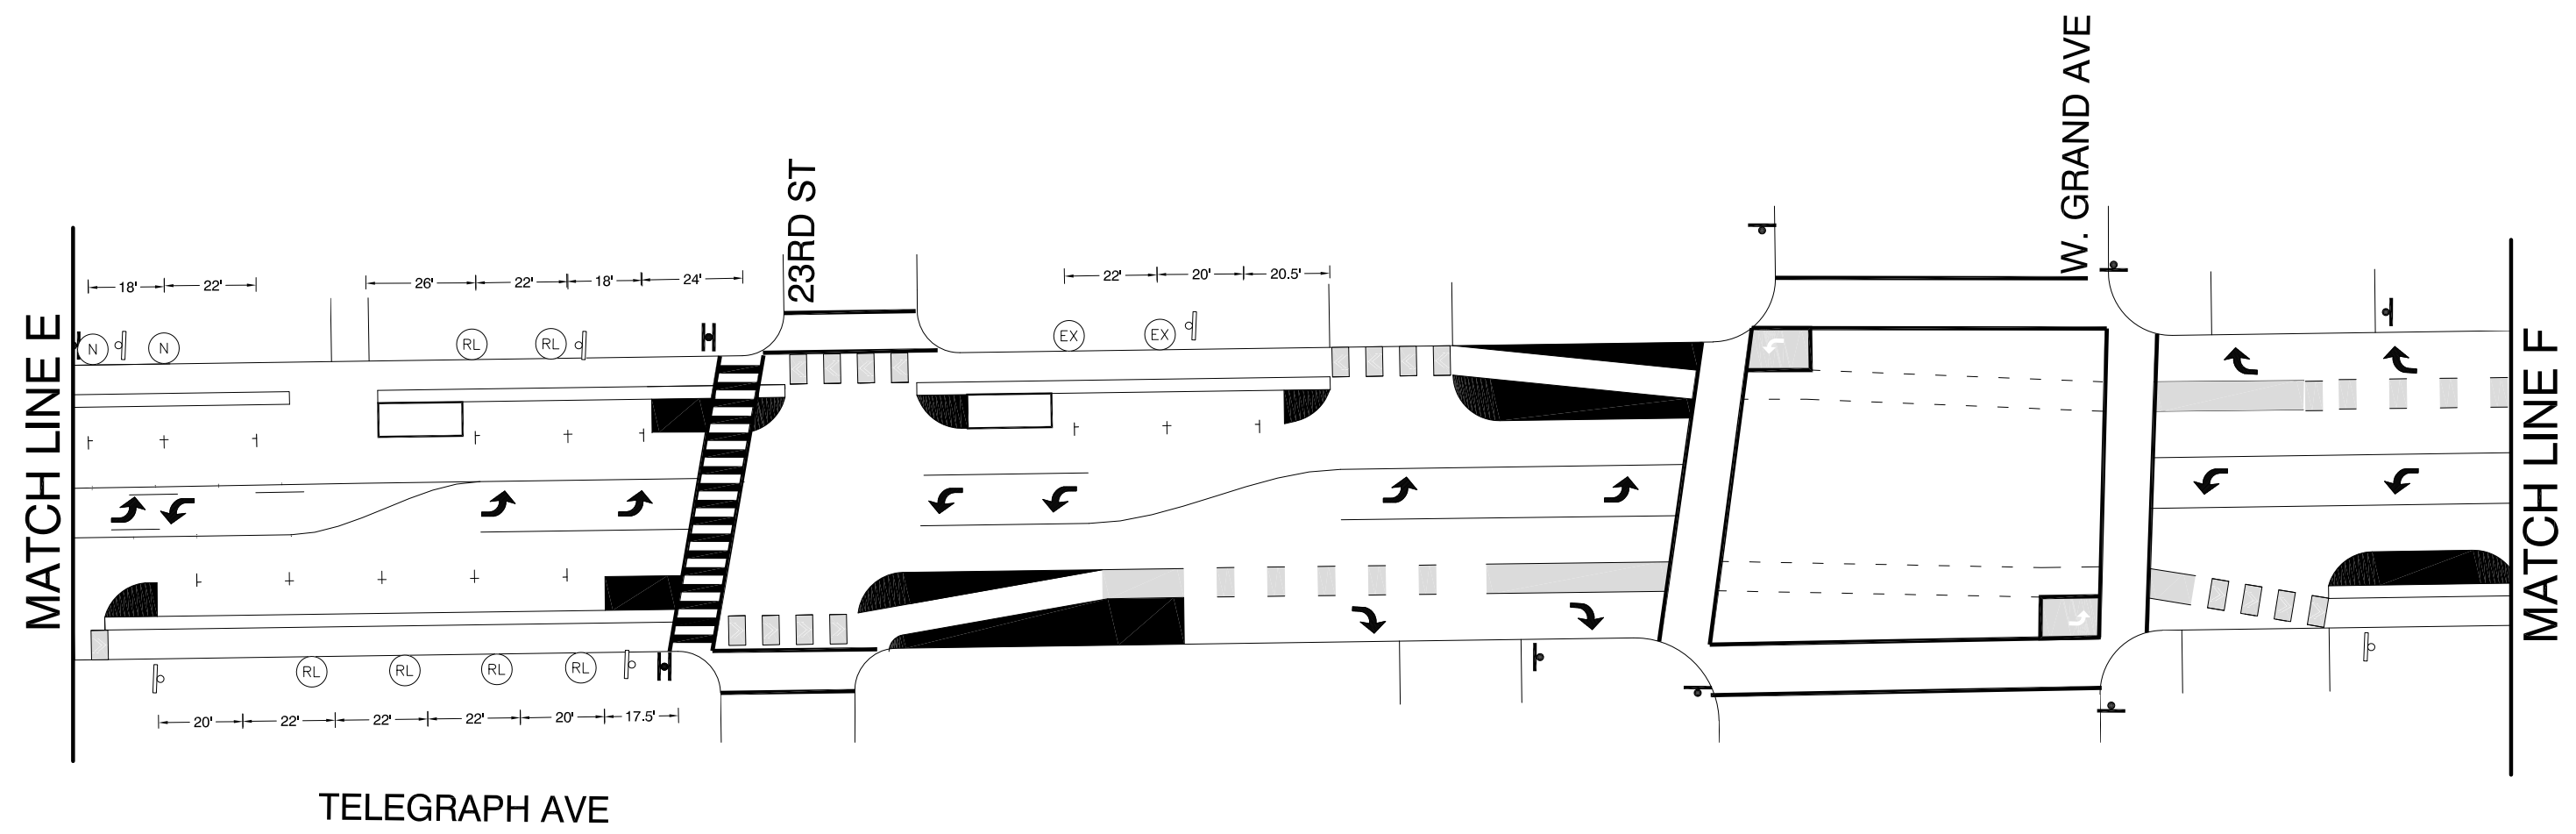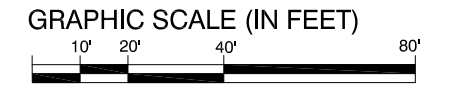

CITY OF OAKLAND
OakDOT | Bicycle and Pedestrian Program
250 FRANK H. OGAWA PLAZA, SUITE 4344 * OAKLAND, CA 94612
(510) 238-3467 * FAX (510) 238-7415

TELEGRAPH AVENUE
COMPLETE STREETS PROJECT
CITY OF OAKLAND

FEHR PEERS
100 Pringle Avenue Walnut Creek, CA 94596
Suite 600 (925) 930-7100

CHECKED BY	PC/MA
DESIGNED BY	RM/CN
DRAWN BY	LC/CW

No.	BY	DATE	REFERENCE

PARKING METER PLAN

AS-BUILT
MAY 2016

PROJECT NO.
CITY OF OAKLAND
WORK ORDER



SCALE:
AS SHOWN
DATE:
Feb. 26, 2018

SHEET NO.
PM-5
5 OF 6

LEGEND (PM-1 TO PM-6)

- (EX) EXISTING PARKING METER TO REMAIN
- (RL) RELOCATED PARKING METER
- (N) NEW PARKING METER

TELEGRAPH AVE

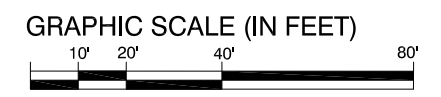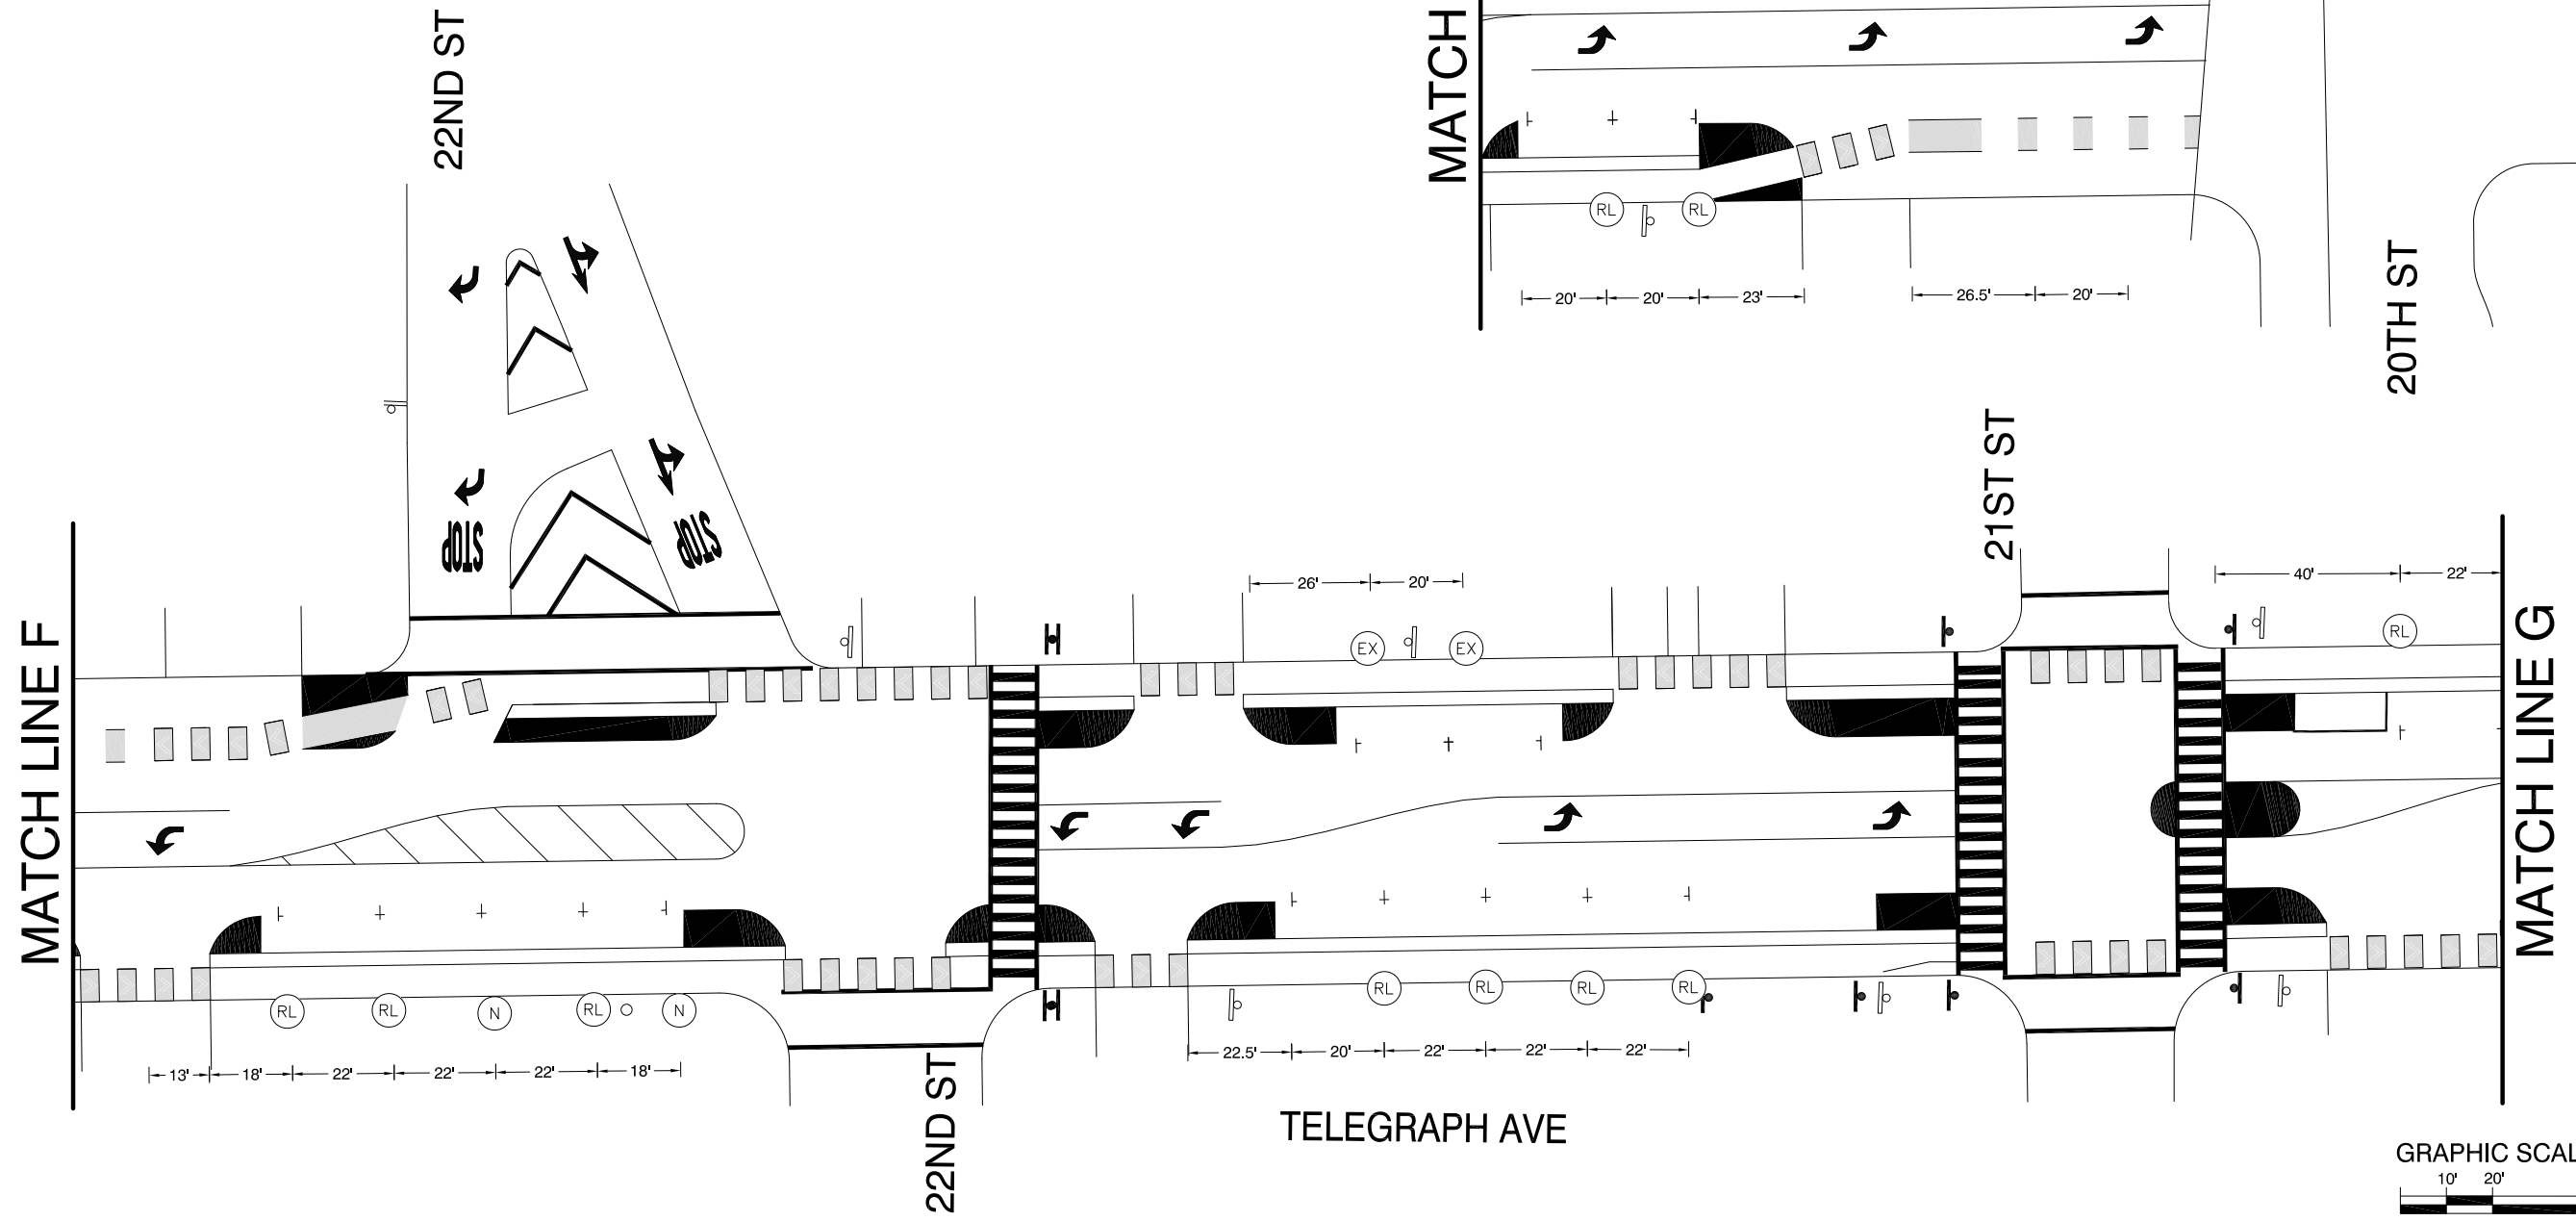

CITY OF OAKLAND
 OakDOT | Bicycle and Pedestrian Program
 250 FRANK H. OGAWA PLAZA, SUITE 4344 • OAKLAND, CA 94612
 (510) 238-3467 • FAX (510) 238-7415

TELEGRAPH AVENUE
 COMPLETE STREETS PROJECT
 CITY OF OAKLAND

FEHR & PEERS
 100 Pringle Avenue Walnut Creek, CA 94596
 Suite 600 (925) 930-7100

CHECKED BY	PC/MA
DESIGNED BY	RM/CN
DRAWN BY	LC/CW

No.	BY	DATE	REFERENCE

PARKING METER PLAN
 AS-BUILT
 MAY 2016

PROJECT NO.
 CITY OF OAKLAND
 WORK ORDER

SCALE:
 AS SHOWN
 DATE:
 Feb. 26, 2018

SHEET NO.
PM-6
 6 OF 6

BROADWAY/ETH AVENUE TO GOLDEN GATE WAY BIKEPEDESTRIAN PROJECT CALBECOTT TUNNEL SETTLEMENT
 DRAWING NAME: C:\p\Program\Projects\TelegraphAve\0_Telegraph_29th-20thSt\Working Docs\CADD\3080-SS1_SSTL_final.dwg
 DATE: 2/26/2018
 PLOTTED BY: Elsie